IREDELL COUNTY HEALTH DEPARTMENT

Statesville Phone TR 3-7271 Mooresville Phone NO 3-1271

PERMIT TO INSTALL SEPTIC TANK

Permit No. 111 Permit Date 6-21- 1972

Owner Paulcase Address Charlotte

Installed By " Address "


Location of Property 1100 to ~~Blacks~~ the Beaten Path go approx ami Sec 9 Lot 2 2

Tank		Capacity		Length of Lines		Fixtures	
Block	( )	1000	(✓)	225'	(✓)	No. of Baths	(2)
Precast	(✓)	1250	( )	250'	( )	Dishwasher	(Not)
		1500	( )	Other		Garbage Grdr.	(not)
		Other				Other	

NOTIFY HEALTH DEPARTMENT AT LEAST EIGHT HOURS BEFORE TANK IS TO BE INSPECTED.

Final Inspection 6-21-1972 Approved (X) Disapproved ( )

Remarks well not located yet

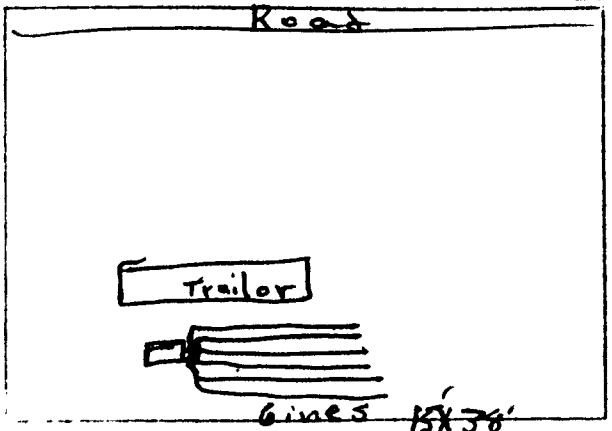

Sketch of Installation

J. C. Moore

Sanitarian