IREDELL COUNTY HEALTH DEPARTMENT

STATESVILLE 704-878-5305 MOORESVILLE 704-664-5281

IMPROVEMENT PERMIT / AUTHORIZATION TO CONSTRUCT / OPERATION PERMIT / EXISTING SYSTEM INSPECTION

PERMIT# 094669 PIN# 4627 51 9108 PT 4627806839 DATE 6/12/01

OWNER OR CONTRACTOR SHAVENDERS DEV. GROUP PHONE: Business 919-469-4738 Home

ADDRESS 11430 EXECUTIVE CIRCLE - CARY NC 27115

LOCATION BRAWLEY SCHOOL RD - TR BLUME - TL BEATEN PATH - TL CICERO - TL SHAVENDERS DRIVE - TR BATHCREEK DR.

SUBDIVISION SHAVENDERS BLUFF BLOCK / SECTION 2D LOT 108 LOT AREA .77AC SITE CLASS. C5 DESIGN FLOW 480GPD L.T.A.R. 3610/FT2

Septic Tank: 1000 Gallons; STB 794 Date 5/11/02

Pump Tank: Gallons; PT Date

Pump Make: Model Serial No.

Nitrification Field: No Fields 1 Square Feet 1200 Linear Feet 400

No Lines 4@100' Trench Width 36" Max Trench Bottom Depth 36" Gravel Depth N/A

☑ New System ☐ Repair System Type: I. ☐ II. ☐ III. ☑ Conventional

System Description: GRAVITY 25% ~~REDUCTION~~

Repair System Description: CP PANEL

Maintenance Agreement Required: ☐ Yes ☑ No

☑ House/Mod. Home No. Bedrooms ~~4~~ X 3

☐ Mobile Home No. Bathrooms 4

☐ Business No. Employees

☐ Other


☐ Slab ☑ Crawl Space ☐ Basement w/plumbing ☐ Basement wo/plumbing

Water Supply: ☑ Individual ☐ Public ☐ Community


Comments/Conditions: Reviewed building plans 11/13/01 Okay to put drive on other side

Comments/Conditions: ~~X~~ 11/13/2001 Changed from 4 Bedroom to 3 Bedroom, Change drainfield to Conventional instead of 25% reduction.

INITIAL SITE SKETCH 1"=50'

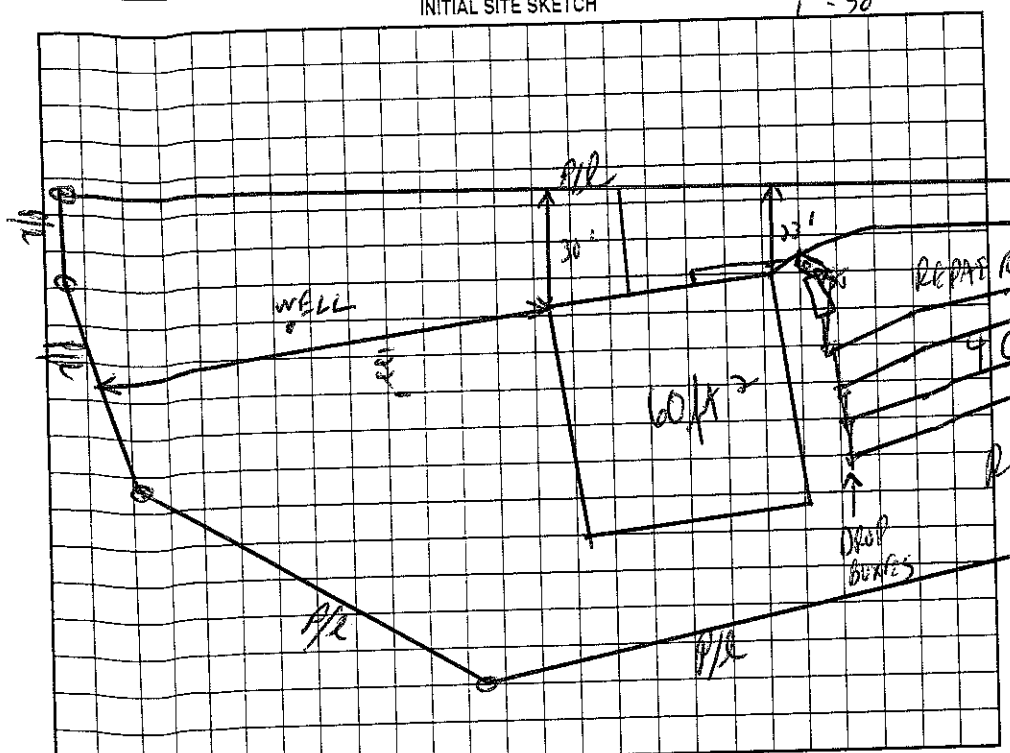

AS BUILT SKETCH

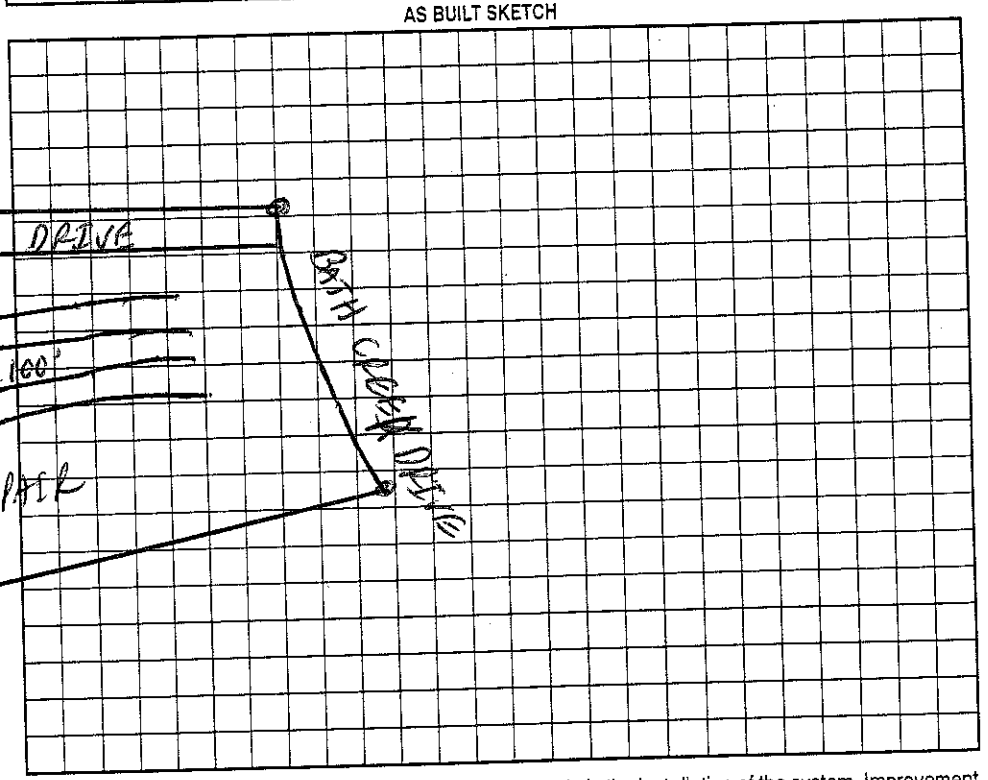

Permit can be suspended or revoked if any false information is supplied toward securing the permit/any unauthorized changes are made to the site/any unauthorized changes are made in the installation of the system. Improvement Permit with plat valid without expiration. Improvement Permit with site plan valid for sixty months. Authorization to Construct is valid for a period equal to that of Improvement Permit – not to exceed sixty months.

Signed: Lee B Fuller date 2-26-01

Improvement Permit by: date 6/12/01

Authorization to Construct by: date 11/12/01

Installed by: Mike Kidd

Operation Permit by: Wesley Sparks RS date 7/29/02

Existing System Inspection by: date

HEALTH DEPT. COPY: WHITE OWNER COPY (FINAL): YELLOW OWNER COPY (INITIAL): PINK