IREDELL COUNTY HEALTH DEPARTMENT

STATESVILLE 704-878-5305 125.00 Paid 3:30 MOORESVILLE 704-664-5281

IMPROVEMENT PERMIT / AUTHORIZATION TO CONSTRUCT / OPERATION PERMIT / EXISTING SYSTEM INSPECTION

PERMIT# 094668 PIN# 4627819108 PT 4627807897 DATE 9/20/01

OWNER OR CONTRACTOR SHAVENDERS DEV. GROUP PHONE: Business 919-469-4738 Home

ADDRESS 1143 D EXECUTIVE CIRCLE CARY NC 27511

LOCATION BRAWLEY SCHOOL - TL BLUME - TL BEATEN PATH - TL SHAVENDERS - TL BATH - ON CT

SUBDIVISION SHAVENDERS BLUFF BLOCK / SECTION 20 LOT 107 LOT AREA 1.025 Ac SITE CLASS. PS DESIGN FLOW 480GPD L.T.A.R. .36 PP/FT²

Septic Tank: 1000 Gallons; STB 625 Date 1/3/02
Pump Tank: 1000 Gallons; PT Date
Pump Make: Model Serial No.
Nitrification Field: No Fields 1 Square Feet 1200 Linear Feet 400
No Lines 4@100' Trench Width 36" Max Trench Bottom Depth 36" Gravel Depth N/A

☑ New System ☐ Repair System Type: I, II, III, IV, V, VI
System Description: PUMP 25% REDUCTION
Repair System Description: SAME
Maintenance Agreement Required: ☐ Yes ☑ No


☑ House/Mod. Home No. Bedrooms 4
☐ Mobile Home No. Bathrooms 4
☐ Business No. Employees
☐ Other
☐ Slab ☑ Crawl Space ☐ Basement w/plumbing ☐ Basement wo/plumbing

Water Supply: ☑ Individual ☐ Public ☐ Community


Comments:/Conditions:

Comments:/Conditions: Gravity

INITIAL SITE SKETCH 1"=50'

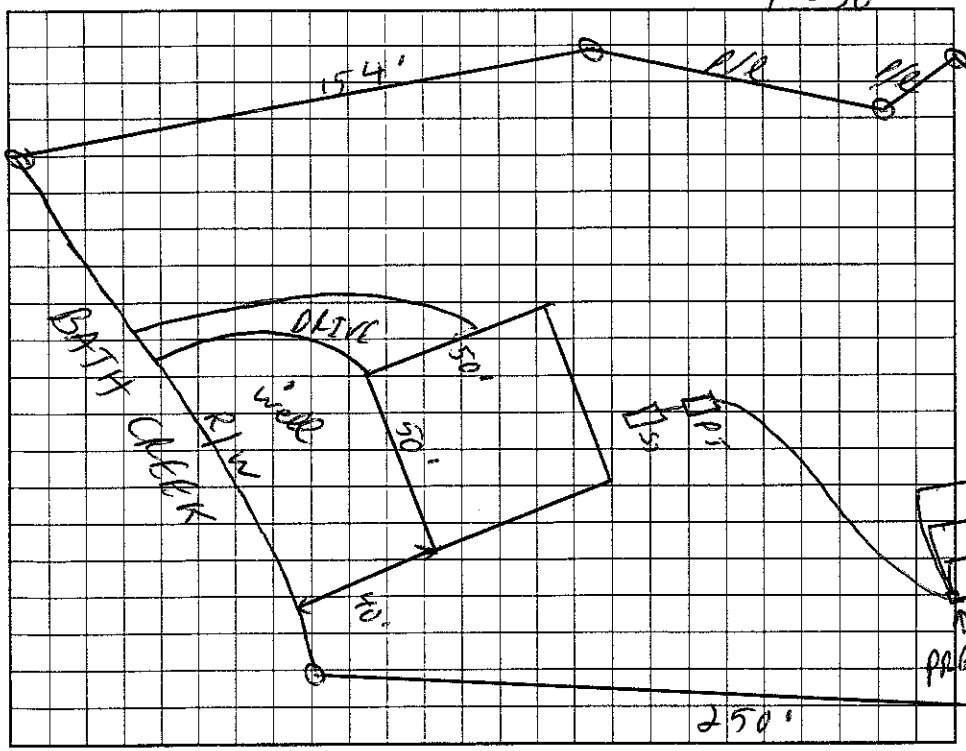

AS BUILT SKETCH

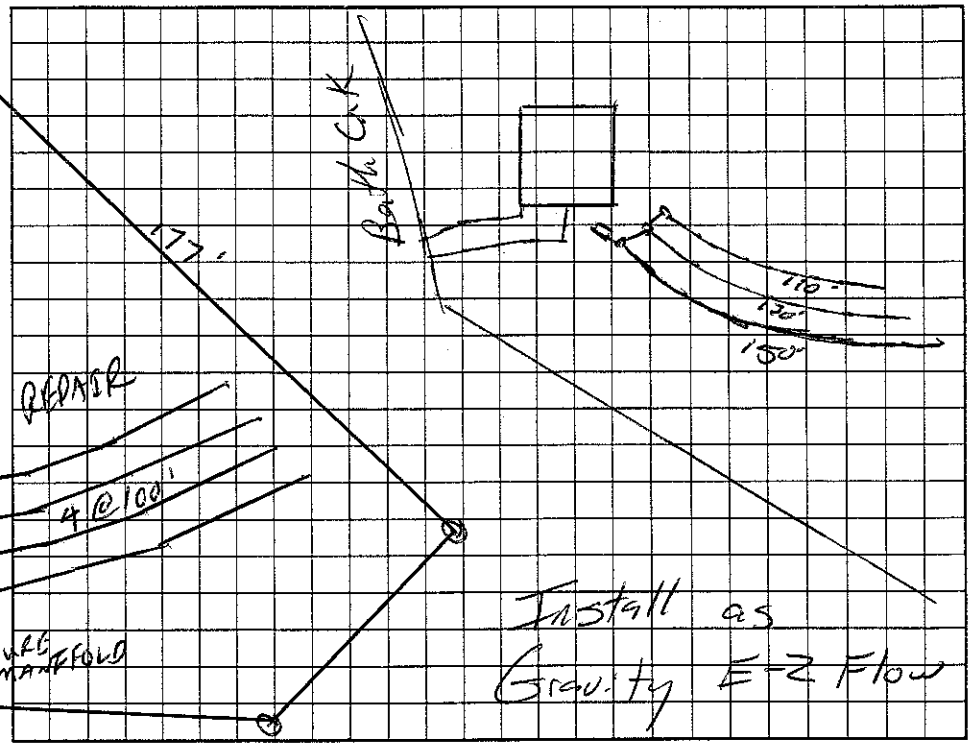

Permit can be suspended or revoked if any false information is supplied toward securing the permit/any unauthorized changes are made to the site/any unauthorized changes are made in the installation of the system. Improvement Permit with plat valid without expiration. Improvement Permit with site plan valid for sixty months. Authorization to Construct is valid for a period equal to that of Improvement Permit – not to exceed sixty months.

Signed: date 10/4/01 Installed by: Upright Grading

Improvement Permit by: RS date 9/20/01 Operation Permit by: RS date 3/25/02

Authorization to Construct by: RS date 11/13/01 Existing System Inspection by: date

HEALTH DEPT. COPY: WHITE OWNER COPY (FINAL): YELLOW OWNER COPY (INITIAL): PINK