IREDELL COUNTY HEALTH DEPARTMENT

STATESVILLE 704-878-5305 130.00 Paid MOORESVILLE 704-664-5281 2:30

IMPROVEMENT PERMIT / AUTHORIZATION TO CONSTRUCT / OPERATION PERMIT / EXISTING SYSTEM INSPECTION

PERMIT# 117696 PIN# 4627 80 9407 DATE 1/30/04

OWNER OR CONTRACTOR Craig Pelchat PHONE: Business 704-663-0181 Home

ADDRESS 132 Redmond Place Mooresville, NC. 28117

LOCATION 1100 TR Blume Rd TL Beaten Path to 714 on (R) side of road

SUBDIVISION CL+T BLOCK / SECTION 9 LOT 19 LOT AREA .99 Ac SITE CLASS. PS DESIGN FLOW 360 L.T.A.R. .3

Septic Tank: 1000 Gallons; STB 794 Date 4-18-04
Pump Tank: 1000 Gallons; PT 983 Date 4-20-04
Pump Make: Goulds Model WFO 7 12H Serial No. S04T01558
Nitrification Field: No Fields 1 Square Feet 900 Linear Feet 300
No Lines 3@100 Trench Width 3' Max Trench Bottom Depth 3' Gravel Depth No

[X] New System [ ] Repair System Type: I, II, (III), IV, V, VI
System Description: PM to 25% Reduced
Repair System Description: < 1983
Maintenance Agreement Required: [ ] Yes [X] No

[X] House/Mod. Home No. Bedrooms 3
[ ] Mobile Home No. Bathrooms 3
[ ] Business No. Employees
[ ] Other


[ ] Slab [X] Crawl Space [ ] Basement w/plumbing [ ] Basement wo/plumbing

Water Supply: [X] Individual [ ] Public [ ] Community


Comments:/Conditions: Installed PVC sleeve under driveway

Comments:/Conditions: Checked tanks, lines & pressure 5/25/04 MS

INITIAL SITE SKETCH

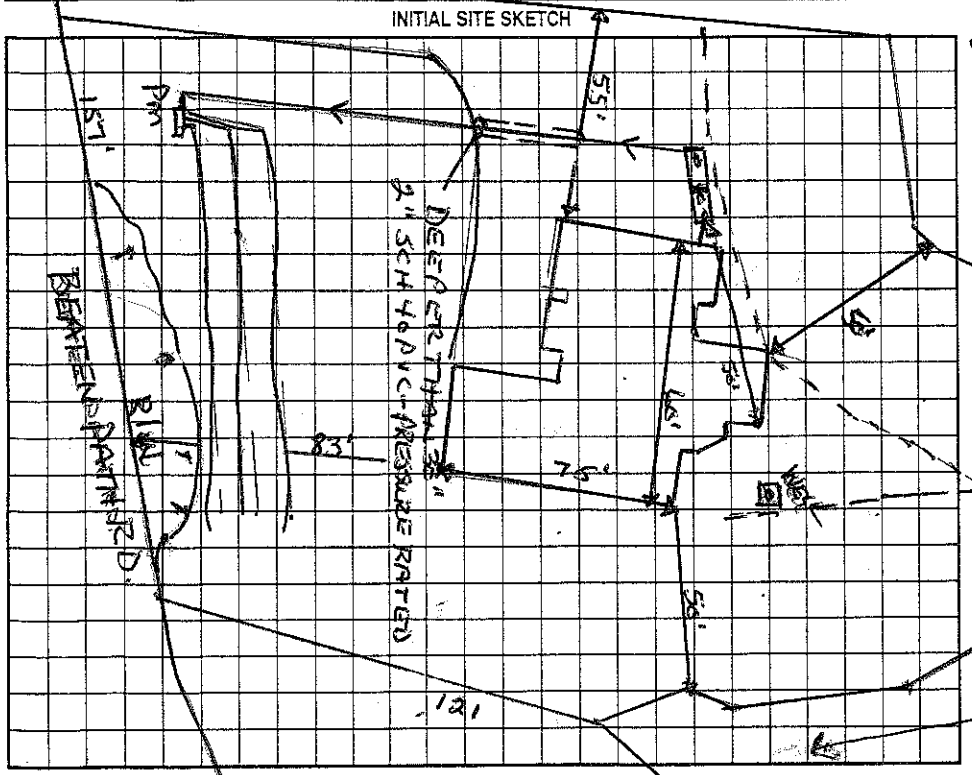

AS BUILT SKETCH

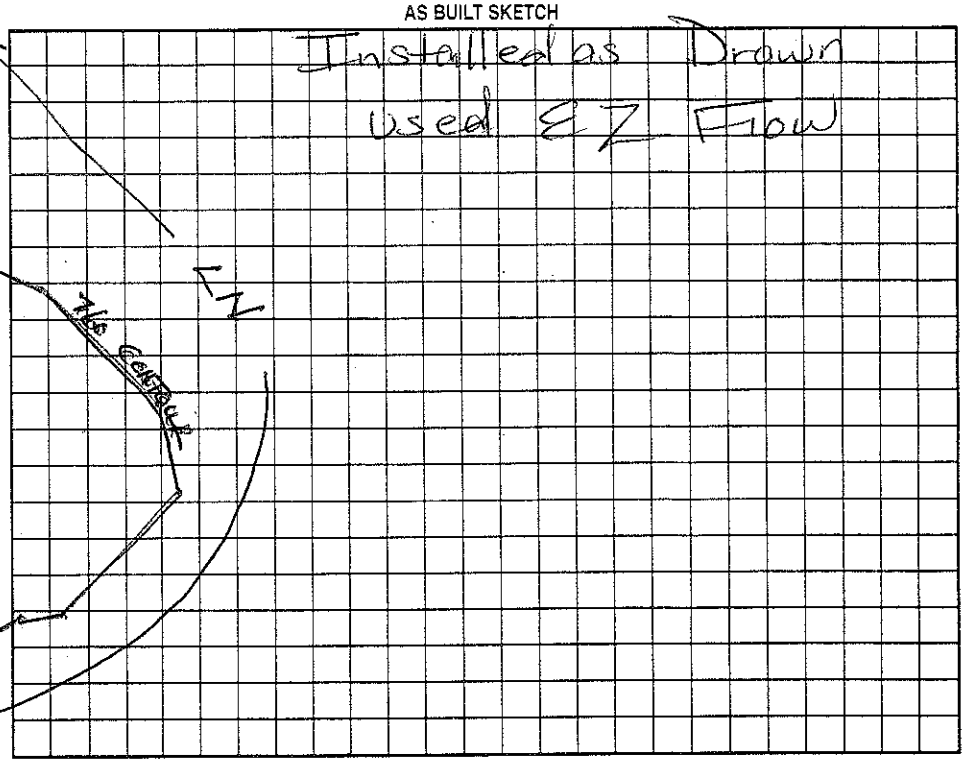

Permit can be suspended or revoked if any false information is supplied toward securing the permit/any unauthorized changes are made to the site/any unauthorized changes are made in the installation of the system. Improvement Permit with plat valid without expiration. Improvement Permit with site plan valid for sixty months. Authorization to Construct is valid for a period equal to that of Improvement Permit – not to exceed sixty months.

Signed: *Craig Pelchat date 2-2-04

Improvement Permit by: Wesley Sparks R.S. date 1/30/04

Authorization to Construct by: Wesley Sparks R.S. date 1/30/04

Installed by: F J Ervin

Operation Permit by: Wesley Sparks R.S. date 6/15/04

Existing System Inspection by: date

HEALTH DEPT. COPY: WHITE OWNER COPY (FINAL): YELLOW OWNER COPY (INITIAL): PINK