IREDELL COUNTY HEALTH DEPARTMENT

STATESVILLE 704-878-5305 50.00 Paid MOORESVILLE 704-664-5281

IMPROVEMENT PERMIT / AUTHORIZATION TO CONSTRUCT / OPERATION PERMIT / EXISTING SYSTEM INSPECTION

PERMIT# 065736 PIN# 4627912991 4627811588 DATE April 20, 01

OWNER OR CONTRACTOR Anthony J Mariano PHONE: Business Home

ADDRESS Old Beaten Path Ln. Mooresville

LOCATION Beaver Dam Rd. TR Blume TL Beaten Path on left

SUBDIVISION Shavendars Bluff BLOCK / SECTION LOT 57 LOT AREA .68Ac SITE CLASS. RS DESIGN FLOW 360 gpd L.T.A.R. .3

Septic Tank: 1000 Gallons; STB 794 Date 3/9/01

Pump Tank: Gallons; PT Date

Pump Make: Model Serial No.

Nitrification Field: No Fields 1 Square Feet 400/600 Linear Feet 200

No Lines 5@40' Trench Width 24" @ or 36" @ Max Trench Bottom Depth 36" Gravel Depth NA

☑ New System ☐ Repair System Type: I, II, (III), IV, V, VI

System Description: Gravity PPBPS

Repair System Description: LPPPBPS

Maintenance Agreement Required: ☐ Yes ☑ No Initially

☑ House/Mod. Home No. Bedrooms 3

☐ Mobile Home No. Bathrooms 3

☐ Business No. Employees

☐ Other


☐ Slab ☑ Crawl Space ☐ Basement w/plumbing ☐ Basement wo/plumbing

Water Supply: ☑ Individual ☐ Public ☐ Community


Comments/Conditions: Some Repair

Comments:/Conditions: 233' 1"=30'

INITIAL SITE SKETCH

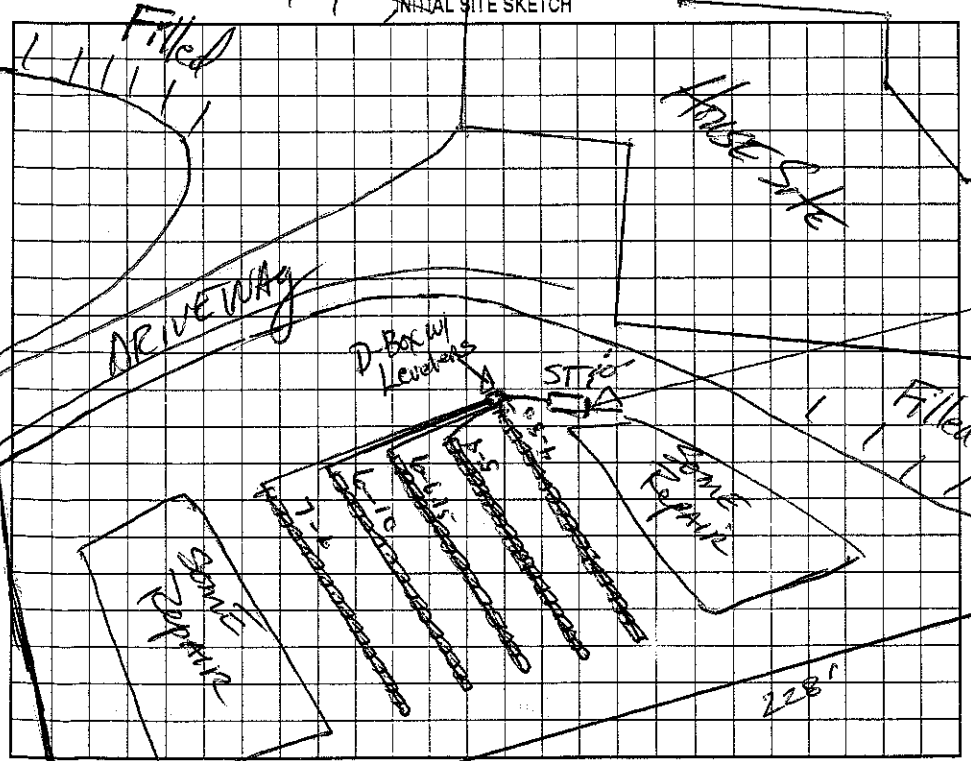

AS BUILT SKETCH

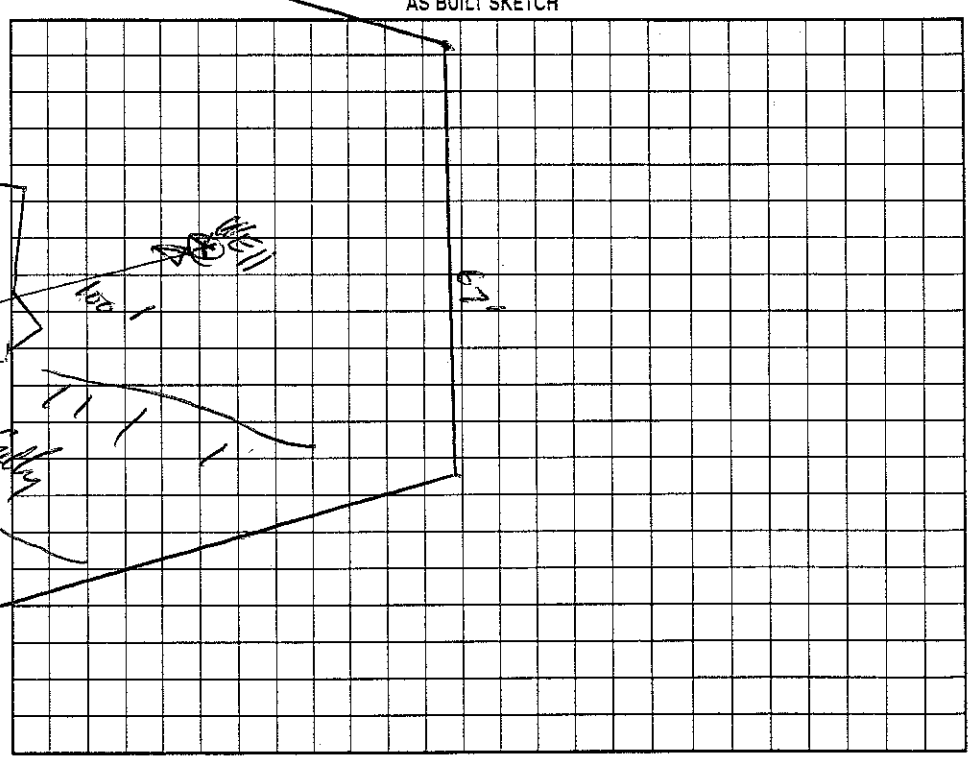

RIM Beaten Path Road

Permit can be suspended or revoked if any false information is supplied toward securing the permit/any unauthorized changes are made to the site/any unauthorized changes are made in the installation of the system. Improvement Permit with plat valid without expiration. Improvement Permit with site plan valid for sixty months. Authorization to Construct is valid for a period equal to that of Improvement Permit – not to exceed sixty months.

Signed date 4-23-01 Installed by: Atlantic Grading

Improvement Permit by: date 4-20-01 Operation Permit by: Wesley Sparks RS. date 4/25/01

Authorization to Construct by: date 4-20-01 Existing System Inspection by: date

HEALTH DEPT. COPY: WHITE OWNER COPY (FINAL): YELLOW OWNER COPY (INITIAL): PINK