IREDELL COUNTY HEALTH DEPARTMENT

STATESVILLE 704-878-5305 MOORESVILLE 704-664-5281

IMPROVEMENT PERMIT / AUTHORIZATION TO CONSTRUCT / OPERATION PERMIT / EXISTING SYSTEM INSP

PERMIT# 065735 PIN# ~~4627912791~~ 4627811793 DATE 4/9/98

OWNER OR CONTRACTOR SHAVENDER'S BLUFF PHONE: Business Home

ADDRESS 189 ASBURY CIRCLE MOORESVILLE

LOCATION BRAWLEY - TR BLUME - TL BEATEN PATH - ON LT

SUBDIVISION SHAVENDER'S BLUFF BLOCK / SECTION LOT 56 LOT AREA .71AC SITE CLASS. B5 DESIGN FLOW 360 L.T.A.R. .3

Septic Tank: 1000 Gallons; STB 794 Date 9/23/98

Pump Tank: Gallons; PT Date

Pump Make: Model Serial No.

Nitrification Field: No Fields 1 Square Feet 700 Linear Feet 300

No Lines 3 @100' Trench Width 36" Max Trench Bottom Depth 36" Gravel Depth N/A

☑ New System ☐ Repair System Type: I, II, ☑ III, IV, V, VI

System Description: GRAVITY CHAMBERS OR HDS

Repair System Description: ~~SAND~~ PANEL

Maintenance Agreement Required: ☐ Yes ☑ No

☑ House/Mod. Home No. Bedrooms 4

☐ Mobile Home No. Bathrooms 4

☐ Business No. Employees

☐ Other


☐ Slab ☑ Crawl Space ☐ Basement w/plumbing ☐ Basement wo/plumbing

Water Supply: ☑ Individual ☐ Public ☐ Community

Comments:/Conditions: 220' N1=40'

Comments:/Conditions: Well Installed

INITIAL SITE SKETCH

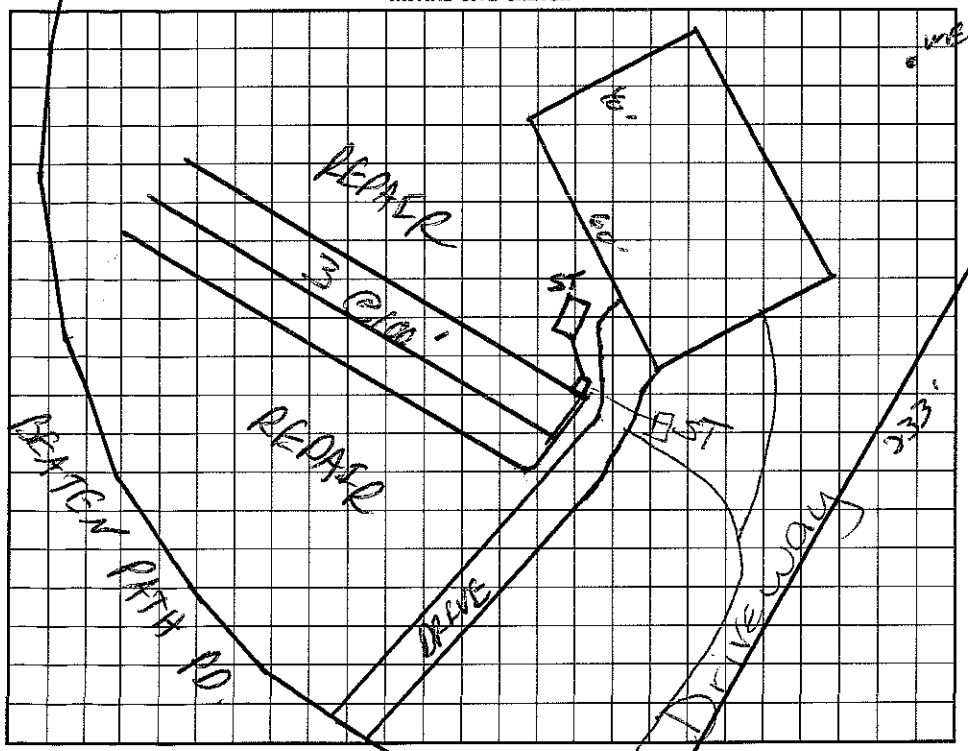

AS BUILT SKETCH

Lines Installed As Drawn

I understand that this permit can be suspended or revoked if any false information is supplied toward securing the permit/any unauthorized changes are made to the site/any unauthorized changes are made in the installation of the system. ~~Improvement Permit with plat valid~~ without expiration. Improvement Permit with site plan valid for sixty months. Authorization to Construct is valid for a period equal to that of Improvement Permit – not to exceed sixty months.

Signed: date 4-9-98 Installed by: Larry Beam Grading

Improvement Permit by: RS date 4/9/98 Operation Permit by: RS date 1/6/99

Authorization to Construct by: RS date 4/9/98 Existing System Inspection by: RS date 1/6/99

HEALTH DEPT. COPY: WHITE INSPECTION COPY (FINAL): GREEN OWNER COPY (FINAL): YELLOW INSPECTION COPY (INITIAL): PINK OWNER COPY (INITIAL): GOLD