IREDELL COUNTY HEALTH DEPARTMENT

STATESVILLE 704-878-5305 130.00 Pd 2 MOORESVILLE 704-664-5281 2:30

IMPROVEMENT PERMIT / AUTHORIZATION TO CONSTRUCT / OPERATION PERMIT / EXISTING SYSTEM INSPECTION

PERMIT# 108453 PIN# 4627812185 DATE 8-29-2002

OWNER OR CONTRACTOR T. Whelan Homes Inc. PHONE: Business 400-8932 Home

ADDRESS 20609 Autumn Breeze Ct Cornelius, NC 28031

LOCATION Brawley School Rd TR Blume Rd TL Beaten Path TL Cicero TL Shavenders Dr. TR Beaten Path 1/4 mi on rt.

SUBDIVISION Shavenders Bluff BLOCK / SECTION LOT 60 LOT AREA .70 Acre SITE CLASS. PS DESIGN FLOW 480 gpd L.T.A.R. .3

Septic Tank: 1000 Gallons; STB 794 Date 2/6/03
Pump Tank: Gallons; PT Date
Pump Make: Model Serial No.
Nitrification Field: No Fields 1 Square Feet 1200' Linear Feet 400'
No Lines 5 Trench Width 36" Max Trench Bottom Depth 36" Gravel Depth N/A

[X] New System [ ] Repair System Type: I, II, III, IV, V, VI
System Description: Gravity-25% Reduction
Repair System Description: LP Panel Block
Maintenance Agreement Required: [ ] Yes [X] No Not Initially


[X] House/Mod. Home No. Bedrooms 4
[ ] Mobile Home No. Bathrooms 4
[ ] Business No. Employees
[ ] Other
[ ] Slab [X] Crawl Space [ ] Basement w/plumbing [ ] Basement wo/plumbing

Water Supply: [X] Individual [ ] Public [ ] Community

Comments/Conditions: Keep Septic System at least 10' from any PL

Comments/Conditions: Note: Tight area for 25% Reduction Drainfield therefore if house print increases then Panel Block Drainfield will be needed.

INITIAL SITE SKETCH Scale 1:50

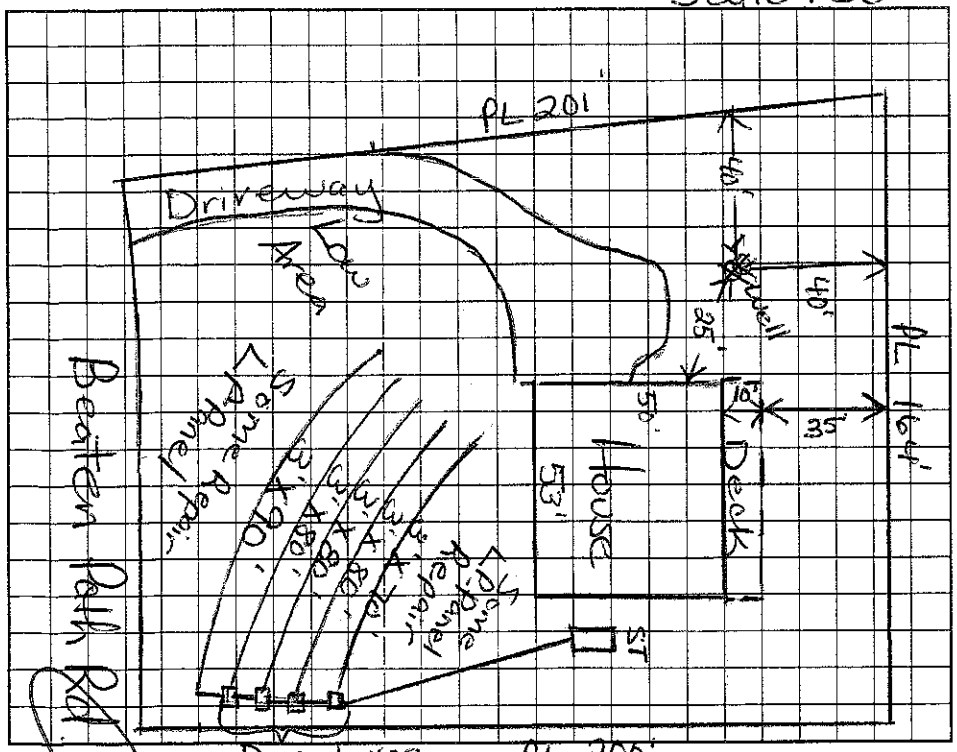

AS BUILT SKETCH

E-Z Flow Installed As Drawn

Permit can be suspended or revoked if any false information is supplied toward securing the permit/any unauthorized changes are made to the site/any unauthorized changes are made in the installation of the system. Improvement Permit with plat valid without expiration. Improvement Permit with site plan valid for sixty months. Authorization to Construct is valid for a period equal to that of Improvement Permit – not to exceed sixty months.

Signed: date 9-4-08 Installed by: Larry Beam

Improvement Permit by: Maria H. Dotson RS date 8/29/2002 Operation Permit by: RS date 3/11/03

Authorization to Construct by: Maria H. Dotson RS date 8/29/2002 Existing System Inspection by: date

HEALTH DEPT. COPY: WHITE OWNER COPY (FINAL): YELLOW OWNER COPY (INITIAL): PINK