#15988

IREDELL COUNTY HEALTH DEPARTMENT

STATESVILLE 704-878-5305 MOORESVILLE 704-664-5281

IMPROVEMENT PERMIT / AUTHORIZATION TO CONSTRUCT / OPERATION PERMIT / EXISTING SYSTEM INSPECTION

330.00 Paid

PERMIT# 065939 PIN# ~~4627-91-2791~~ 4627812370 DATE 5/13/04

OWNER OR CONTRACTOR Anglacing Homes Inc. PHONE: Business 704-907-9250 Home

ADDRESS PO Box 610 Cornelius, NC. 28031-0610

LOCATION 1100 TR Blume TL Beaten Path on (L) past Honeysuckle Ln.

SUBDIVISION Shoreham Bluff BLOCK / SECTION LOT 59 LOT AREA .69 SITE CLASS. PS DESIGN FLOW 360 L.T.A.R. .3

Septic Tank: 1000 Gallons; STB 312 Date 2-8-04
Pump Tank: Gallons; PT Date
Pump Make: Model Serial No.
Nitrification Field: No Fields 1 Square Feet 400 Linear Feet 200
No Lines 4@50 Trench Width 2-3 Max Trench Bottom Depth 3' Gravel Depth NA


[X] New System [ ] Repair System Type: I, II, [III], IV, V, VI
System Description: GRAV - 16" PPBPS
Repair System Description: Same Type
Maintenance Agreement Required: [ ] Yes [X] No

[X] House/Mod. Home No. Bedrooms 3
[ ] Mobile Home No. Bathrooms 3
[ ] Business No. Employees
[ ] Other
[ ] Slab [ ] Crawl Space [ ] Basement w/plumbing [ ] Basement wo/plumbing

Water Supply: [X] Individual [ ] Public [ ] Community

Comments:/Conditions:

INITIAL SITE SKETCH

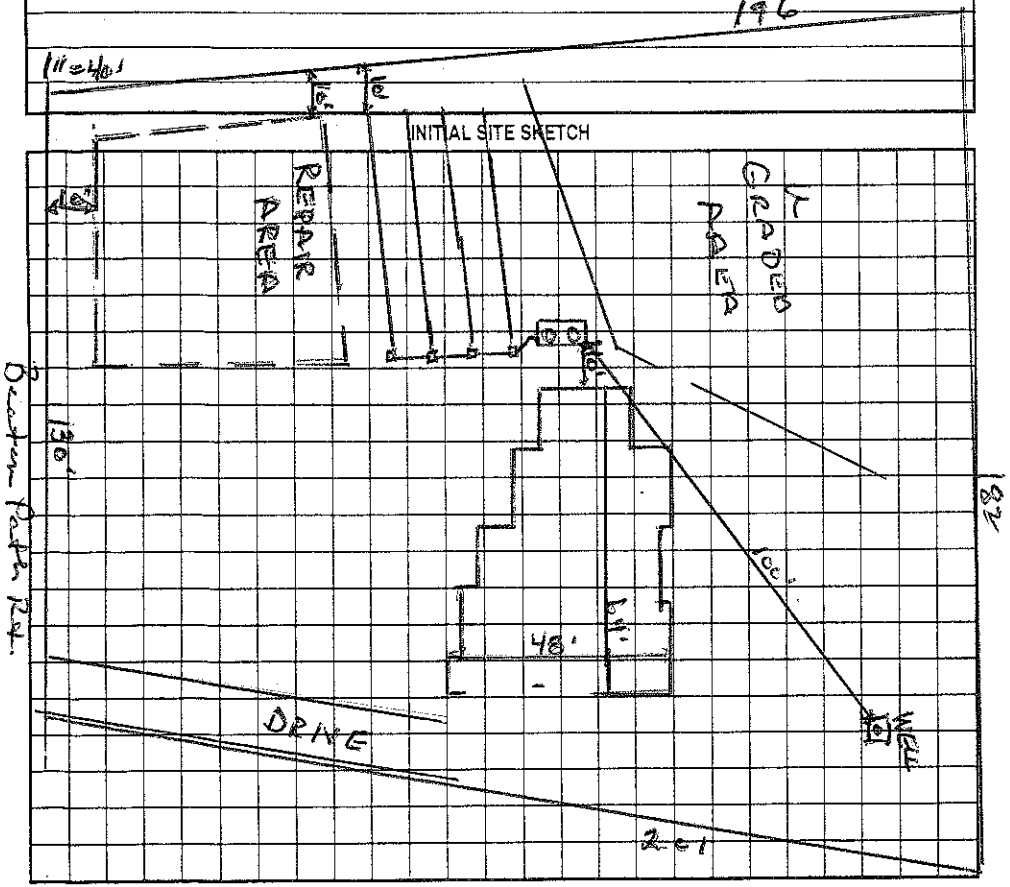

Comments:/Conditions: 5/19/04 Checked tanks & 3 of 4 lines
5/20/04 Checked 4th line; requested Installer Add 1 more panel to last trench. Inst. Used 3' trench.

AS BUILT SKETCH

Installed Essentially as Drawn

Permit can be suspended or revoked if any false information is supplied toward securing the permit/any unauthorized changes are made to the site/any unauthorized changes are made in the installation of the system. Improvement Permit with plat valid without expiration. Improvement Permit with site plan valid for sixty months. Authorization to Construct is valid for a period equal to that of Improvement Permit – not to exceed sixty months.

Signed: [signature] date 5-18-04
Improvement Permit by: Wesley Sparks R.S. date 5/13/04
Authorization to Construct by: Wesley Sparks R.S. date 5/13/04

Installed by: Marty Tucker
Operation Permit by: Mark Hilton R.S. date 5/20/04
Existing System Inspection by: date

HEALTH DEPT. COPY: WHITE OWNER COPY (FINAL): YELLOW OWNER COPY (INITIAL): PINK