C105

IREDELL COUNTY HEALTH DEPARTMENT

STATESVILLE 704-878-5305 MOORESVILLE 704-664-5281

IMPROVEMENT PERMIT / AUTHORIZATION TO CONSTRUCT / OPERATION PERMIT / EXISTING SYSTEM INSPECTION

PERMIT# 065733 PIN# ~~4627912791~~ 4627813756 DATE 4/9/98

OWNER OR CONTRACTOR SHAVENDER'S DEV PHONE: Business Home

ADDRESS 189 ASBURY CIRCLE, MOORESVILLE.

LOCATION BRAWLEY SCHOOL - TR BLUME - TL BEATEN PATH - ON LT B4 HONEYSUCKLE LN

SUBDIVISION SHAVENDER'S BLOCK / SECTION LOT 55 LOT AREA .694C SITE CLASS. PS DESIGN FLOW 360 L.T.A.R. 3

Septic Tank: 1000 Gallons; STB 794 Date 12/25/98

Pump Tank: Gallons; PT Date

Pump Make: Model Serial No.

Nitrification Field: No Fields 1 Square Feet ~~1000~~ 900 Linear Feet 300

No Lines 3@100' Trench Width 36" Max Trench Bottom Depth 36" Gravel Depth N/A

☑ New System ☐ Repair System Type: I, II, III, IV, V, VI

System Description: GRAVITY CHAMBERS OR ADS PANEL

Repair System Description: ~~SAND~~ PANEL

Maintenance Agreement Required: ☐ Yes ☑ No

☑ House/Mod. Home No. Bedrooms 3

☐ Mobile Home No. Bathrooms 3

☐ Business No. Employees

☐ Other

☐ Slab ☑ Crawl Space ☐ Basement w/plumbing ☐ Basement wo/plumbing


Water Supply: ☑ Individual ☐ Public ☐ Community

Comments:/Conditions:

Comments:/Conditions:

67
64½
63

INITIAL SITE SKETCH

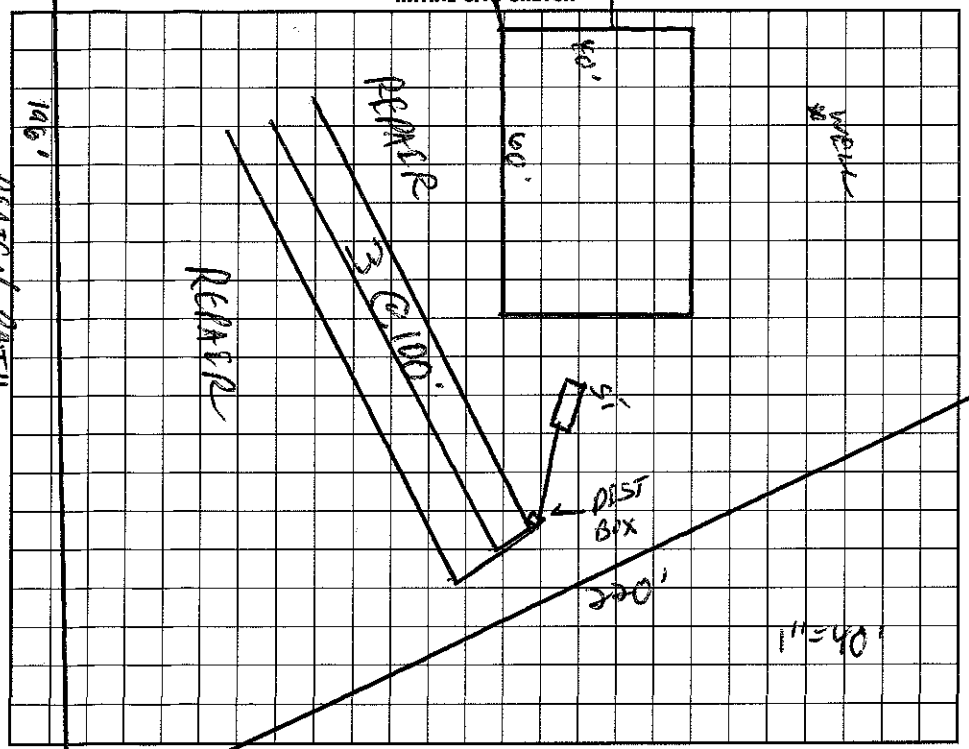

AS BUILT SKETCH

I understand that this permit can be suspended or revoked if any false information is supplied toward securing the permit/any unauthorized changes are made to the site/any unauthorized changes are made in the installation of the system. Improvement Permit with plat valid without expiration. Improvement Permit with site plan valid for sixty months. Authorization to Construct is valid for a period equal to that of Improvement Permit – not to exceed sixty months.

Signed: date 4-9-98 Installed by: ~~LATH~~/EDGE BEAM

Improvement Permit by: C M Thomas RS date 4/9/98 Operation Permit by: date 3/23/99

Authorization to Construct by: C M Thomas RS date 4/9/98 Existing System Inspection by: date

HEALTH DEPT. COPY: WHITE INSPECTION COPY (FINAL): GREEN OWNER COPY (FINAL): YELLOW INSPECTION COPY (INITIAL): PINK OWNER COPY (INITIAL): GOLD