IREDELL COUNTY HEALTH DEPARTMENT

STATESVILLE 704-878-5305 50.00 Paid MOORESVILLE 704-664-5281 4:00

IMPROVEMENT PERMIT / AUTHORIZATION TO CONSTRUCT / OPERATION PERMIT / EXISTING SYSTEM INSPECTION

PERMIT# 094673 PIN# ~~4627-81-9405~~ 4627-81-4396 DATE 1/30/02

OWNER OR CONTRACTOR John Kearney PHONE: Business 336-667-0700 Home

ADDRESS PO Box 56 Wilkesboro NC 28697

LOCATION Brawley Sch, TR Blume, TL Boston Path, TL Cicero, TL Shavenders, TR Bath Creek on Lt.

SUBDIVISION Shavenders Bluff BLOCK / SECTION 2F LOT 1/2 LOT AREA 1.18 AC SITE CLASS PS DESIGN FLOW ~~300~~ 360 L.T.A.R. 0.3

Septic Tank: 1000 Gallons; STB 854 Date 2-19-02
Pump Tank: 1000 Gallons; PT 1169 Date 11-11-01
Pump Make: Zoeller BN140B Model No. Sta-rite
Nitrification Field: No Fields 1 Square Feet 420 Linear Feet 210
No Lines 3 @70 Trench Width 24" Max Trench Bottom Depth 36" Gravel Depth —

☒ New System ☐ Repair System Type: I, II, III, (IV), V, VI
System Description: LP Panel
Repair System Description: Same
Maintenance Agreement Required: ☒ Yes ☐ No


☒ House/Mod. Home No. Bedrooms 3
☐ Mobile Home No. Bathrooms 3
☐ Business No. Employees
☐ Other
☐ Slab ☐ Crawl Space ☒ Basement w/plumbing ☐ Basement wo/plumbing

Water Supply: ☒ Individual ☐ Public ☐ Community

Comments:/Conditions: ~~Add 11/2002 - Change for Block~~

Comments:/Conditions: Grey filter installed
Check Float tree
Lines 1 & 2 checked 4/25/2002
line 3 checked 4/26/2002

INITIAL SITE SKETCH 1" = 50'

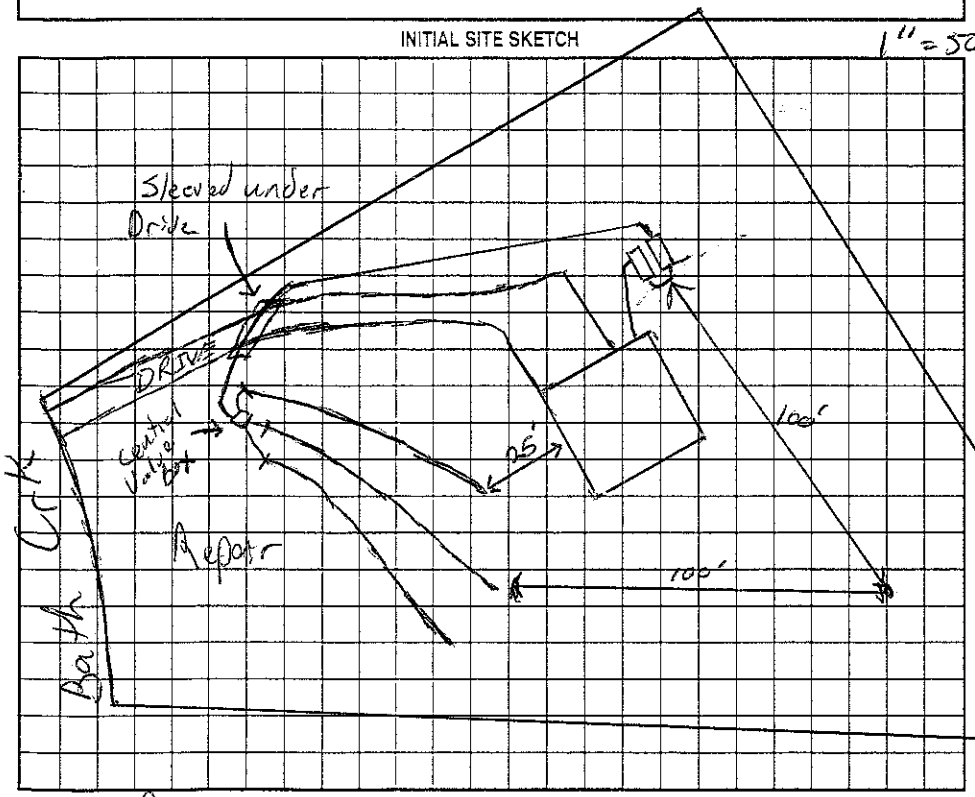

AS BUILT SKETCH

(Used concrete boxes around each valve (3 valves)
Panel Block Drainfield
installed as Shown

Permit can be suspended or revoked if any false information is supplied toward securing the permit/any unauthorized changes are made to the site/any unauthorized changes are made in the installation of the system. Improvement Permit with plat valid without expiration. Improvement Permit with site plan valid for sixty months. Authorization to Construct is valid for a period equal to that of Improvement Permit – not to exceed sixty months.

Signed: John C. Kearney date Installed by: Sterling Church - Church's Backhoe Service

Improvement Permit by: RS date 1/30/02 Operation Permit by: Matthew Dotson RS date 7/23/2002

Authorization to Construct by: RS date 1/30/02 Existing System Inspection by: date

HEALTH DEPT. COPY: WHITE OWNER COPY (FINAL): YELLOW OWNER COPY (INITIAL): PINK