IREDELL COUNTY HEALTH DEPARTMENT

STATESVILLE 704-878-5305 50.00 paid MOORESVILLE 704-664-5281 4.00

IMPROVEMENT PERMIT / AUTHORIZATION TO CONSTRUCT / OPERATION PERMIT / EXISTING SYSTEM INSPECTION

PERMIT# 094673 PIN# ~~4627-81-9405~~ 4627-81-4396 DATE 4/30/02

OWNER OR CONTRACTOR John Kearey PHONE: Business 336-667-0700 Home

ADDRESS PO Box 56 Wilkesboro NC 28097

LOCATION Brawley Sch, TR Bhse, TL Boxter Path, TL Cicero, TL Shavenders, TR Bath Creek on Lt.

SUBDIVISION Shavenders Bluff BLOCK / SECTION ~~2~~ LOT 112 LOT AREA 1.18 AC SITE CLASS. PS DESIGN FLOW 360 L.T.A.R. 0.3

Septic Tank: 1000 Gallons; STB 854 Date 2-19-02
Pump Tank: 1000 Gallons; PT 1169 Date 11-11-01
Pump Make: Zoeller BN140B Serial No 514220
Nitrification Field: No Fields 1 Square Feet 420 Linear Feet 210
No Lines 3@70 Trench Width 24" Max Trench Bottom Depth 36" Gravel Depth —

☒ New System ☐ Repair System Type: I. II. III. IV. V. VI
System Description: LP Panel
Repair System Description: Same
Maintenance Agreement Required: ☒ Yes ☐ No


☒ House/Mod. Home No. Bedrooms 3
☐ Mobile Home No. Bathrooms 3
☐ Business No. Employees
☐ Other
☐ Slab ☐ Crawl Space ☒ Basement w/plumbing ☐ Basement wo/plumbing

Water Supply: ☒ Individual ☐ Public ☐ Community

Comments:/Conditions: AJA.11203 - Code # for Pump

Comments:/Conditions: Grey filter installed
Check Float free
Lines 1 & 2 checked. 4/25/2002
line 3 checked 4/26/2002

INITIAL SITE SKETCH

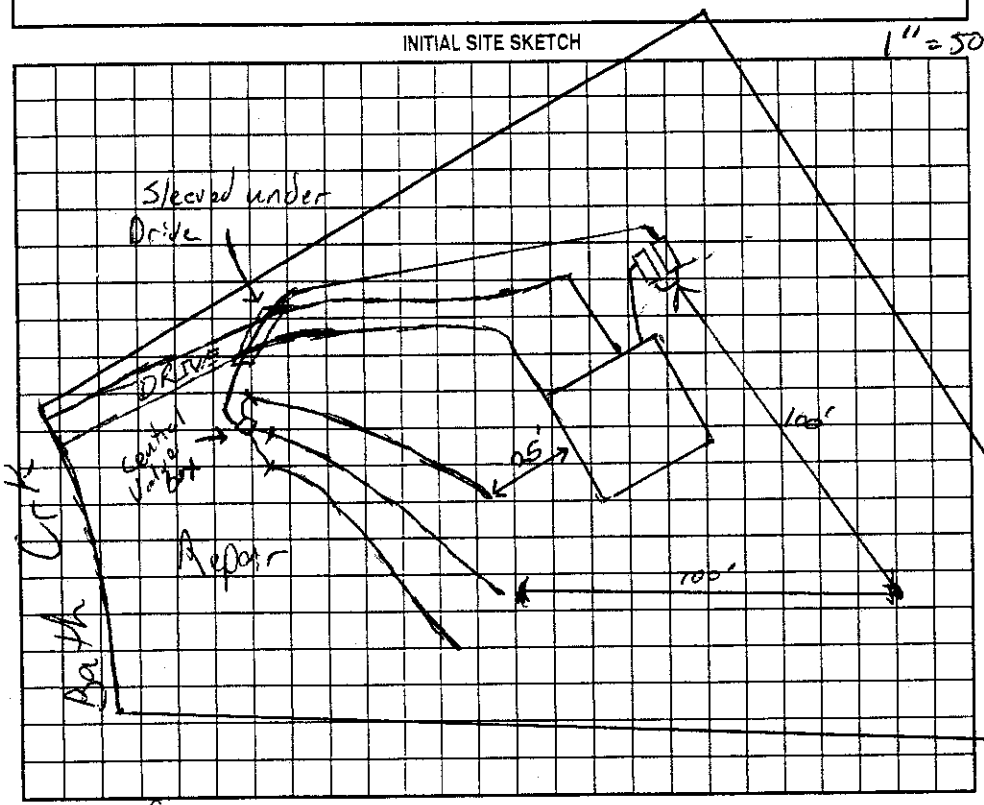

AS BUILT SKETCH

Used concrete boxes around each valve (3 valves)
Panel Block Drainfield installed as Shown

Permit can be suspended or revoked if any false information is supplied toward securing the permit/any unauthorized changes are made to the site/any unauthorized changes are made in the installation of the system. Improvement Permit with plat valid without expiration. Improvement Permit with site plan valid for sixty months. Authorization to Construct is valid for a period equal to that of Improvement Permit – not to exceed sixty months.

Signed: John C. Kearey date

Improvement Permit by: RS date 1/30/02

Authorization to Construct by: RS date 1/30/02

Installed by: Sterling Church - Church's Backhoe Service

Operation Permit by: Marian H. Dobson RS date 7/23/2002

Existing System Inspection by: date

HEALTH DEPT. COPY: WHITE OWNER COPY (FINAL): YELLOW OWNER COPY (INITIAL): PINK