IREDELL COUNTY HEALTH DEPARTMENT

STATESVILLE 704-878-5305 MOORESVILLE 704-664-5281

IMPROVEMENT PERMIT / AUTHORIZATION TO CONSTRUCT / OPERATION PERMIT / EXISTING SYSTEM INSPECTION

PERMIT# 94672 PIN# 4627819108 PT 4627815231 Tim DATE 4/26/2002

OWNER OR CONTRACTOR T. Whelan Homes Inc. PHONE: Business 400-8932 Home

ADDRESS 20609 Autumn Breeze Ct. Cornelius NC 28117

LOCATION Brawley School Rd TR Blume TL Beaten Path TL Cicero TL Shavenders TR Bath on left

SUBDIVISION Shavenders Blvd BLOCK / SECTION 2P LOT 111 LOT AREA .84 Acre SITE CLASS. PS DESIGN FLOW 360 gpd L.T.A.R. .3

Septic Tank: 1000 Gallons; STB 794 Date 3/26/02
Pump Tank: 1000 Gallons; PT 293 Date 4/2/02
Pump Make: ZOELLER Model N-152A Serial No. 1-02
Nitrification Field: No Fields 1 Square Feet 900' Linear Feet 300'
No Lines 3@100' Trench Width 36" Max Trench Bottom Depth 36" Gravel Depth N/A

☒ New System ☐ Repair System Type: I, II, (III), IV, V, VI
System Description: Pump-PM-25% Reduction
Repair System Description: Pump-Innovative
Maintenance Agreement Required: ☐ Yes ☐ No


☒ House/Mod. Home No. Bedrooms 3
☐ Mobile Home No. Bathrooms 3
☐ Business No. Employees
☐ Other
☐ Slab ☒ Crawl Space ☐ Basement w/plumbing ☐ Basement wo/plumbing

Water Supply: ☒ Individual ☐ Public ☐ Community

Comments:/Conditions:

Comments:/Conditions:

INITIAL SITE SKETCH Scale 1:50

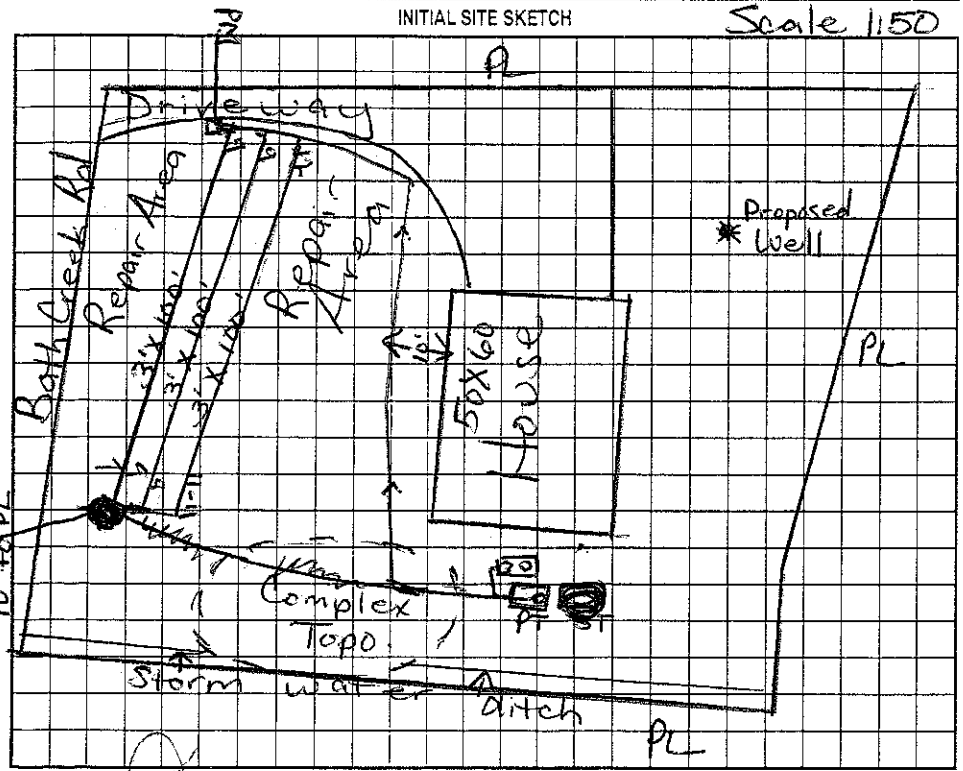

AS BUILT SKETCH

Permit can be suspended or revoked if any false information is supplied toward securing the permit/any unauthorized changes are made to the site/any unauthorized changes are made in the installation of the system. Improvement Permit with plat valid without expiration. Improvement Permit with site plan valid for sixty months. Authorization to Construct is valid for a period equal to that of Improvement Permit – not to exceed sixty months.

Signed: date Installed by: Larry Beam

Improvement Permit by: Maria H.H. Dotson R.S. date 4/26/2002 Operation Permit by: R.S. date 5/25/02

Authorization to Construct by: Maria H.H. Dotson R.S. date 4/26/2002 Existing System Inspection by: date

HEALTH DEPT. COPY: WHITE OWNER COPY (FINAL): YELLOW OWNER COPY (INITIAL): PINK