IREDELL COUNTY HEALTH DEPARTMENT

STATESVILLE 704-878-5305 MOORESVILLE 704-664-5281

IMPROVEMENT PERMIT / AUTHORIZATION TO CONSTRUCT / OPERATION PERMIT / EXISTING SYSTEM INSPECTION

PERMIT# 094674/32357 PIN# 4627-81-9708 PT 4027815502 DATE 12/20/04

OWNER OR CONTRACTOR Heritage Homes OTC PHONE: Business 704-309-5452 Home

ADDRESS PO Box 3333 Mooresville NC 28117

LOCATION BSR, TR Blum, TL Beaton Path, TL Cicero, TL Shavender, TR Rath, on Lt

SUBDIVISION Shavenders Bluff BLOCK / SECTION 2 LOT 113 LOT AREA 0.73AC SITE CLASS. PS DESIGN FLOW 720 L.T.A.R. 0.3

Septic Tank: 1500 Gallons; STB 444 Date

Pump Tank: Gallons; PT Date

Pump Make: Model Serial No.

Nitrification Field: No Fields 1 Square Feet 1800 Linear Feet 600

No Lines 5@120 Trench Width 36" Max Trench Bottom Depth 36" Gravel Depth —

☒ New System ☐ Repair System Type: I, II, III, IV, V, VI

System Description: Gravity 25% Reduct

Repair System Description: LP Panel Block

Maintenance Agreement Required: ☐ Yes ☒ No

☒ House/Mod. Home ☐ Mobile Home ☐ Business ☐ Other

No. Bedrooms 6 No. Bathrooms 4 No. Employees


☐ Slab ☒ Crawl Space ☐ Basement w/plumbing ☐ Basement wo/plumbing

Water Supply: ☒ Individual ☐ Public ☐ Community


Comments:/Conditions:

Comments:/Conditions:

INITIAL SITE SKETCH

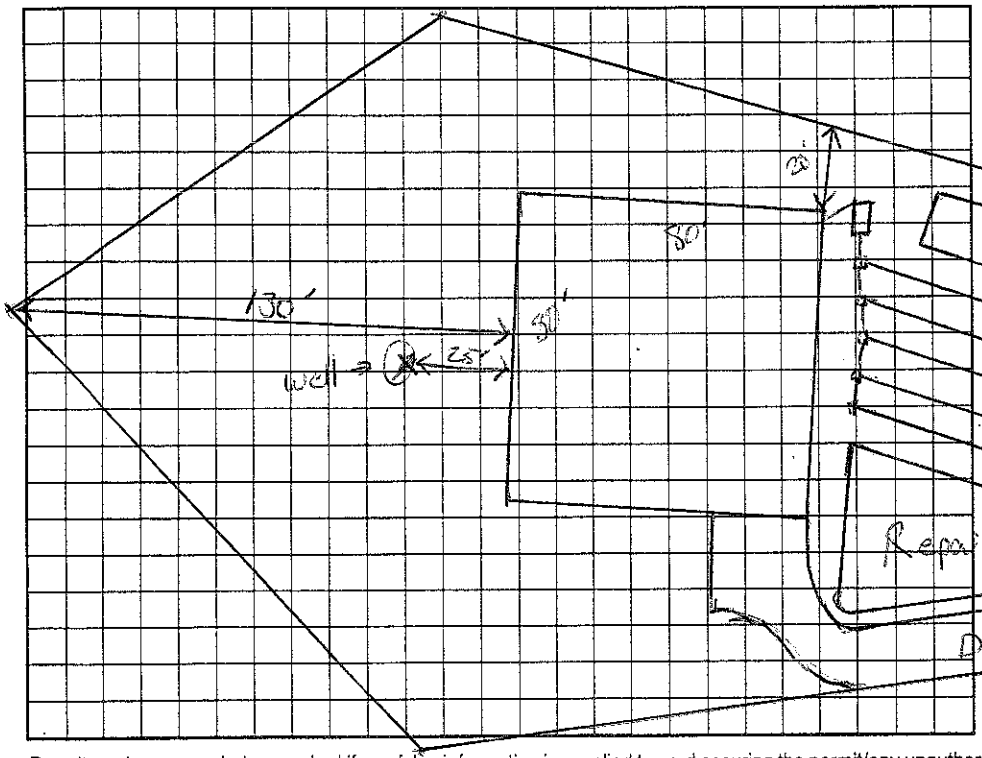

AS BUILT SKETCH

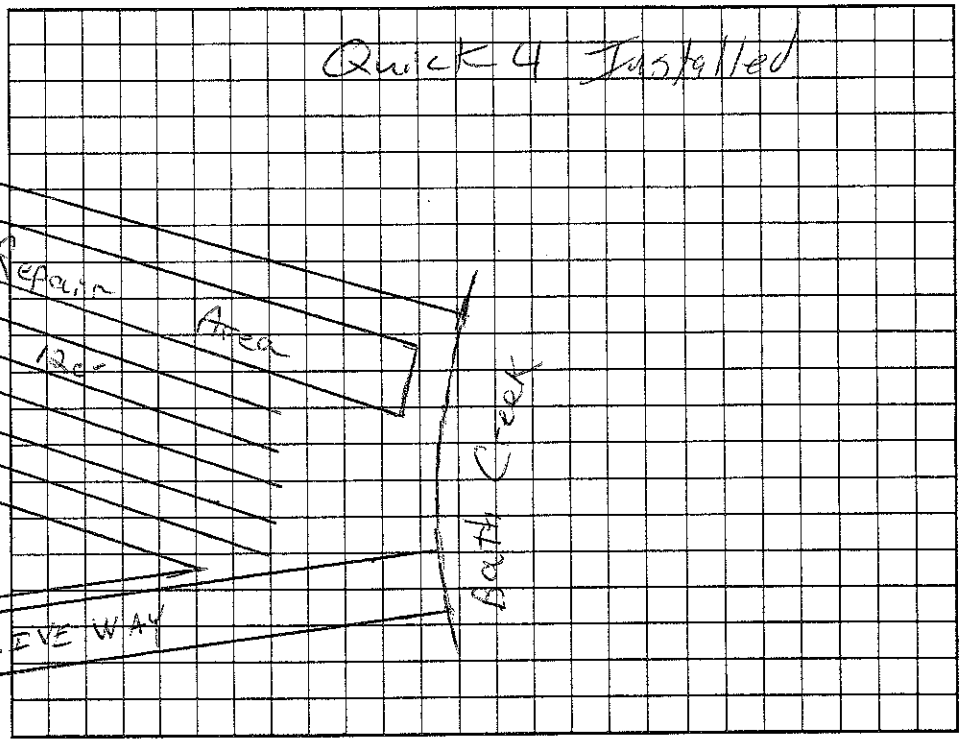

Permit can be suspended or revoked if any false information is supplied toward securing the permit/any unauthorized changes are made to the site/any unauthorized changes are made in the installation of the system. Improvement Permit with plat valid without expiration. Improvement Permit with site plan valid for sixty months. Authorization to Construct is valid for a period equal to that of Improvement Permit – not to exceed sixty months.

Signed: Mark S. Faulk date 1/5/05 Installed by: Piedmont Septic

Improvement Permit by: RS date 12/20/04 Operation Permit by: RS date 5/23/06

Authorization to Construct by: RS date 12/20/04 Existing System Inspection by: date

HEALTH DEPT. COPY: WHITE OWNER COPY (FINAL): YELLOW OWNER COPY (INITIAL): PINK