IREDELL COUNTY HEALTH DEPARTMENT

STATESVILLE 704-878-5305 50.00 Paid 2nd MOORESVILLE 704-664-5281

IMPROVEMENT PERMIT / AUTHORIZATION TO CONSTRUCT / OPERATION PERMIT / EXISTING SYSTEM INSPECTION

PERMIT# 044684 PIN# 4621 81 9108 PT 4027815355 DATE 10/19/01

OWNER OR CONTRACTOR Atkinson Custom Homes PHONE: Business 506-9074 Home

ADDRESS 790 River Ridge Ln. Lexington NC 27295

LOCATION Brawley Sch. TR Blume, TL Beeton Path, TL Cicero, TL Shavenders, TR Bath Creek, on Rt at end

SUBDIVISION Shavenders Bluff BLOCK / SECTION LOT 119 LOT AREA 0.79 AC. SITE CLASS. PS DESIGN FLOW 480 L.T.A.R. 0.3

Septic Tank: 1000 Gallons; STB 794 Date 12/11/01

Pump Tank: Gallons; PT Date

Pump Make: Model Serial No.

Nitrification Field: No Fields 1 Square Feet 1200 Linear Feet 400

No Lines 5@80' Trench Width 36" Max Trench Bottom Depth 36" Gravel Depth —

☒ New System ☐ Repair System Type: I, II, (III), IV, V, VI

System Description: Gravity 25% Reduction

Repair System Description: Gravity Panel

Maintenance Agreement Required: ☐ Yes ☒ No

☒ House/Mod. Home ☐ Mobile Home ☐ Business ☐ Other

No. Bedrooms 4 No. Bathrooms 2½ No. Employees


Water Supply: ☒ Individual ☐ Public ☐ Community

☐ Slab ☒ Crawl Space ☐ Basement w/plumbing ☐ Basement wo/plumbing

Comments:/Conditions:

Comments:/Conditions: 4/9/02 checked drainfield Ch. Plastic installed in same location shown on IP-AC.

INITIAL SITE SKETCH 1" = 50'

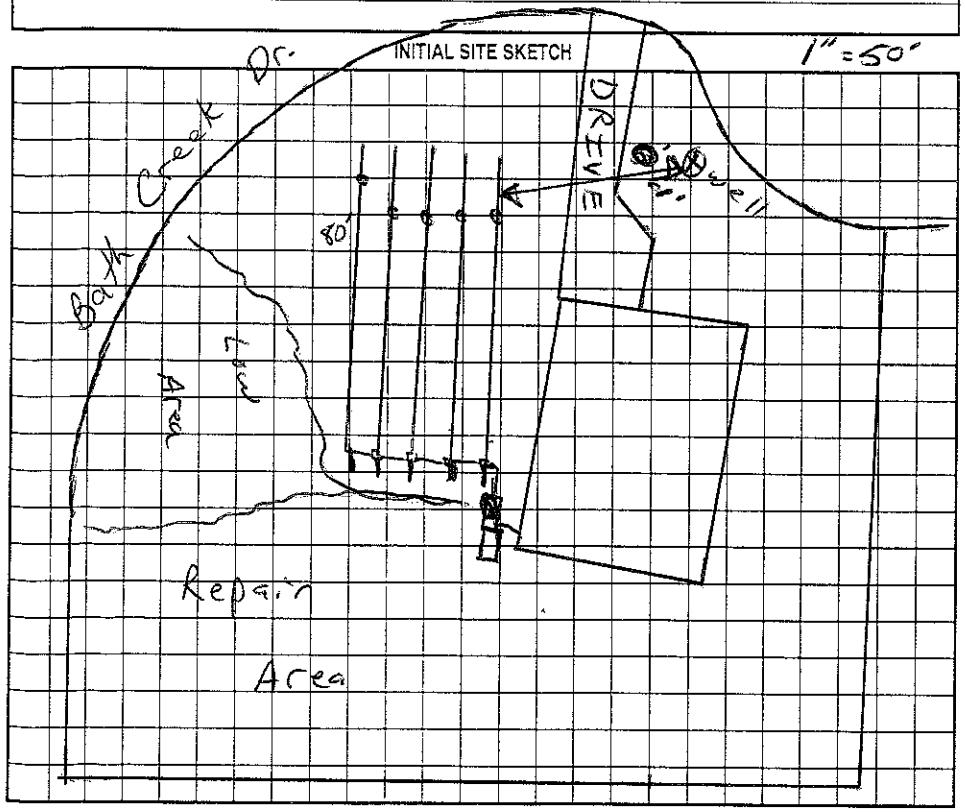

AS BUILT SKETCH

Permit can be suspended or revoked if any false information is supplied toward securing the permit/any unauthorized changes are made to the site/any unauthorized changes are made in the installation of the system. Improvement Permit with plat valid without expiration. Improvement Permit with site plan valid for sixty months. Authorization to Construct is valid for a period equal to that of Improvement Permit – not to exceed sixty months.

Signed: date 10/19/01 Installed by: Mashead Const.

Improvement Permit by: RSI date 10/19/01 Operation Permit by: Wesley Sparks RS. date 4/12/02

Authorization to Construct by: RSI date 10/19/01 Existing System Inspection by: date

HEALTH DEPT. COPY: WHITE OWNER COPY (FINAL): YELLOW OWNER COPY (INITIAL): PINK