IREDELL COUNTY HEALTH DEPARTMENT

STATESVILLE 704-878-5305 MOORESVILLE 704-664-5281

IMPROVEMENT PERMIT / AUTHORIZATION TO CONSTRUCT / OPERATION PERMIT / EXISTING SYSTEM INSPECTION

PERMIT# 94686 PIN# 4627 81 9708 PT 4627 81 8180 DATE 6/15/01

OWNER OR CONTRACTOR SHAVENDERS DEV GROUP / DUPONT PHONE: Business 919-469-4738 Home

ADDRESS 1143 EXECUTIVE CIRCLE - CARY NC 27511

LOCATION BRAWLEY SCHOOL - TR BLUME - TL BEAVER PATH - TL CICERO - TL SHAVENDERS - TR BATH-ON RT

SUBDIVISION SHAVENDERS BLUFF BLOCK / SECTION 20 LOT 121 LOT AREA .72 AC SITE CLASS PS DESIGN FLOW 480GPD L.T.A.R. .36GPD/FT²

Septic Tank: 1000 Gallons; STB 10/2 Date 11/3/01

Pump Tank: Gallons; PT Date

Pump Make: Model Serial No.

Nitrification Field: No Fields 1 Square Feet 1200 Linear Feet 400

No Lines 4@100' Trench Width 36" Max Trench Bottom Depth 36" Gravel Depth N/A

☑ New System ☐ Repair System Type: I, II, III, IV, V, VI

System Description: GRAVITY 25% REDUCTION

Repair System Description: LP PANEL / INNOVATIVE

Maintenance Agreement Required: ☐ Yes ☑ No

☑ House/Mod. Home No. Bedrooms 4

☐ Mobile Home No. Bathrooms 4

☐ Business No. Employees

☐ Other


☐ Slab ☑ Crawl Space ☐ Basement w/plumbing ☐ Basement wo/plumbing

Water Supply: ☑ Individual ☐ Public ☐ Community


Comments:/Conditions: * DRIVE MAY BE SWITCHED TO OTHER SIDE *

Comments:/Conditions:

INITIAL SITE SKETCH 1" = 50'

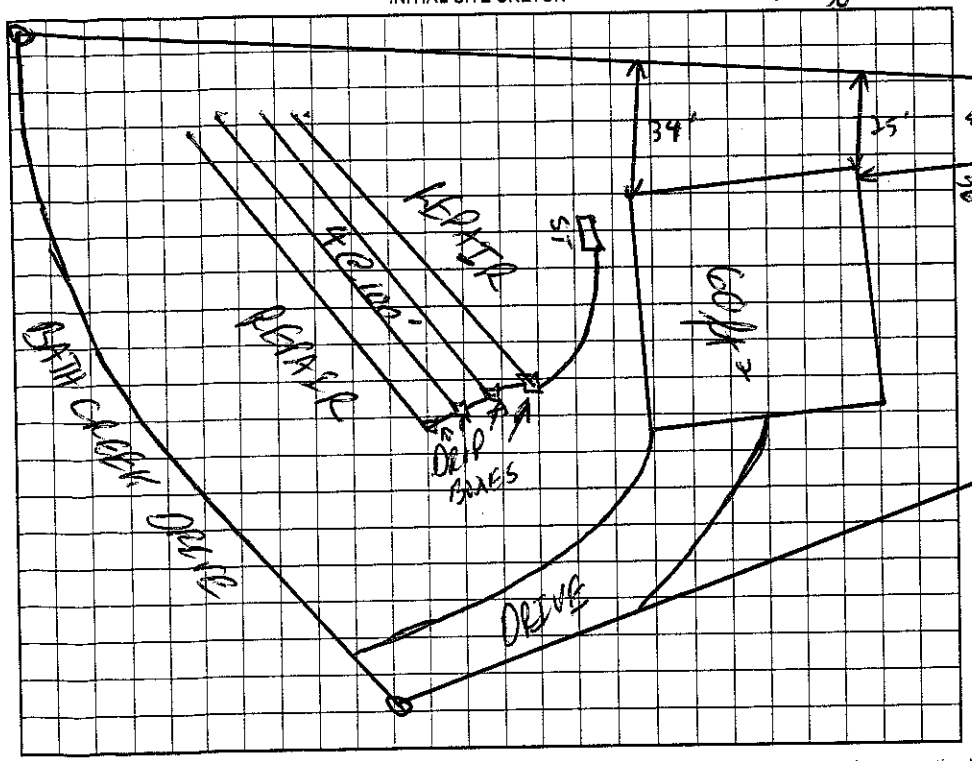

AS BUILT SKETCH

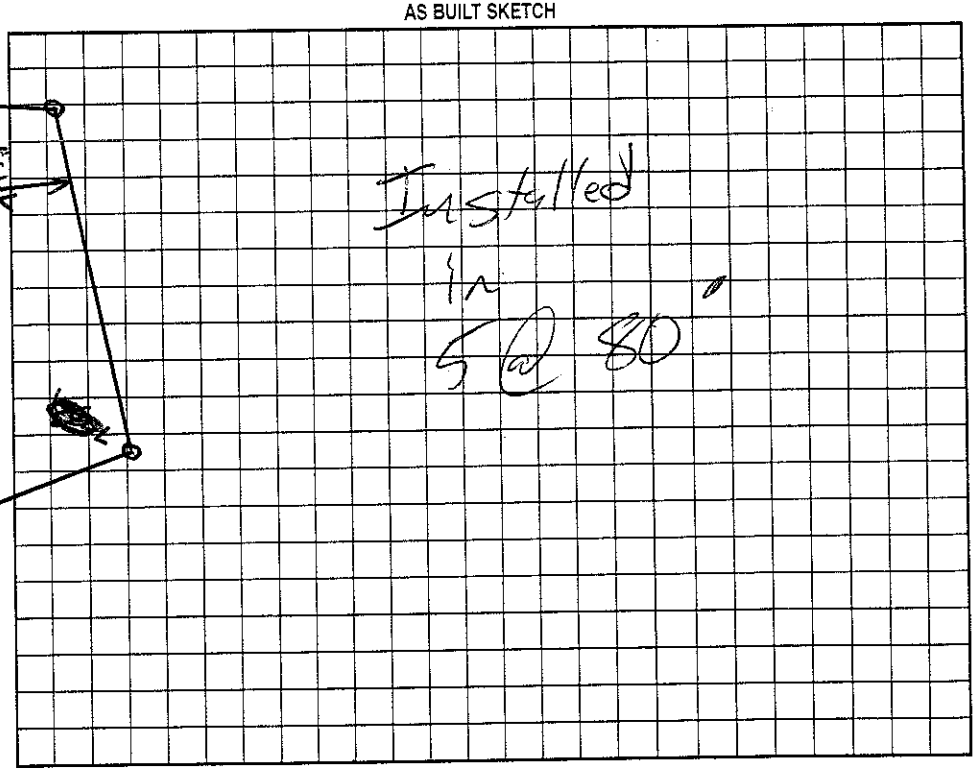

Permit can be suspended or revoked if any false information is supplied toward securing the permit/any unauthorized changes are made to the site/any unauthorized changes are made in the installation of the system. Improvement Permit with plat valid without expiration. Improvement Permit with site plan valid for sixty months. Authorization to Construct is valid for a period equal to that of Improvement Permit – not to exceed sixty months.

Signed: date 7-26-01 Installed by: Aberthy

Improvement Permit by: RS date 6/15/01 Operation Permit by: RS date 4/1/02

Authorization to Construct by: RS date 9/20/01 Existing System Inspection by: date

HEALTH DEPT. COPY: WHITE OWNER COPY (FINAL): YELLOW OWNER COPY (INITIAL): PINK