1:00

IREDELL COUNTY HEALTH DEPARTMENT

STATESVILLE 704-878-5305 MOORESVILLE 704-664-5281

IMPROVEMENT PERMIT / AUTHORIZATION TO CONSTRUCT / OPERATION PERMIT / EXISTING SYSTEM INSPECTION

PERMIT# 094682 PIN# 4627 81 9108 PT 4627 81 9350 DATE 6/14/01

OWNER OR CONTRACTOR SHAVENDERS DEV GROUP / KEVIN HUFFSTETLER PHONE: Business 919-469-4738 Home

ADDRESS 1143 D EXECUTIVE CIRCLE - CARY NC 27511

LOCATION BRANLEY SCHOOL - TR BLUME - TL BEATEN PATH - TL CICERO - TL SHAVENDERS - TR BATH - AT END

SUBDIVISION SHAVENDERS BLUFF BLOCK / SECTION 2D LOT 118 LOT AREA .75AC SITE CLASS. PS DESIGN FLOW 450GPD L.T.A.R. .36GPD/FT²

Septic Tank: 1000 Gallons; STB 312 Date 5/16/02
Pump Tank: 1000 Gallons; PT 283 Date 5/26/02
Pump Make: MYERS Model ME-SQ511 Serial No. 1/02
Nitrification Field: No Fields 1 Square Feet 1200 Linear Feet 400
No Lines 4@100' Trench Width 36" Max Trench Bottom Depth 36" Gravel Depth NA

☑ New System ☐ Repair System Type: I, II, III, IV, V, VI
System Description: PUMP 25% REDUCTION
Repair System Description: LP PANEL
Maintenance Agreement Required: ☐ Yes ☑ No

☑ House/Mod. Home No. Bedrooms 4
☐ Mobile Home No. Bathrooms 4
☐ Business No. Employees
☐ Other


Water Supply: ☑ Individual ☐ Public ☐ Community

☐ Slab ☑ Crawl Space ☑ Basement w/plumbing ☐ Basement wo/plumbing


Comments:/Conditions: 1) DO NOT CUT OUT FOR POSITIVE DRAINAGE - BUILDUP ONLY - 11/14/01

Comments:/Conditions: (PATIAL ONLY) * NO FULL BASEMENT

INITIAL SITE SKETCH

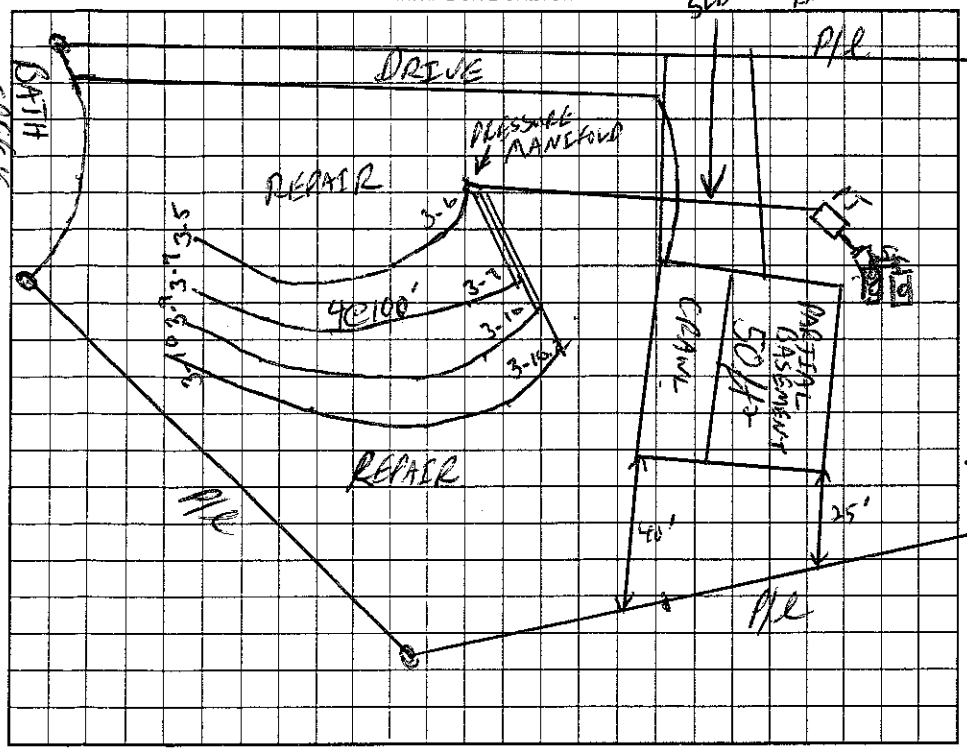

AS BUILT SKETCH

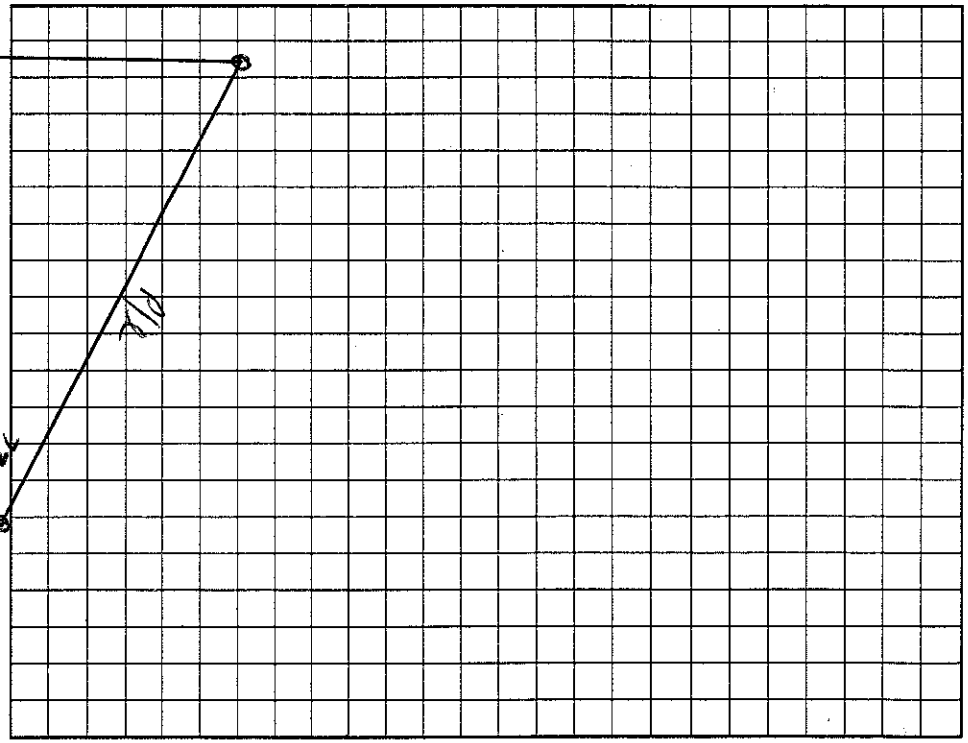

Permit can be suspended or revoked if any false information is supplied toward securing the permit/any unauthorized changes are made to the site/any unauthorized changes are made in the installation of the system. Improvement Permit with plat valid without expiration. Improvement Permit with site plan valid for sixty months. Authorization to Construct is valid for a period equal to that of Improvement Permit – not to exceed sixty months.

Signed: [signature] date 7-26-01

Improvement Permit by: C. Bryan RS date 6/14/01

Authorization to Construct by: C. [signature] RS date 11/14/01

Installed by: Tim Ammons

Operation Permit by: Wesley Sparks RS. date 9/6/02

Existing System Inspection by: date

HEALTH DEPT. COPY: WHITE OWNER COPY (FINAL): YELLOW OWNER COPY (INITIAL): PINK