11106

IREDELL COUNTY HEALTH DEPARTMENT

STATESVILLE 704-878-5305 MOORESVILLE 704-664-5281

IMPROVEMENT PERMIT / AUTHORIZATION TO CONSTRUCT / OPERATION PERMIT / EXISTING SYSTEM INSPECTION

PERMIT# 94681 PIN# ~~4627-81-9108-PT~~ 4627-81-9494 DATE 6/14/01

OWNER OR CONTRACTOR SHAVENDERS DEV GROUP / Dupont Grp PHONE: Business 919-464-4738 Home

ADDRESS 1143 D EXECUTIVE CIRCLE. CARY NC 27511

LOCATION BRAWLEY SCHOOL - TR BLUME - TL BEAVER PATH - TL CICERO - TR SHAVENDERS (TR) BATH-AT END

SUBDIVISION SHAVENDERS BLUFF BLOCK / SECTION 2F LOT 117 LOT AREA .72 Ac SITE CLASS. B5 DESIGN FLOW 360 GPD L.T.A.R. .3 GPD/FT²

Septic Tank: 1000 Gallons; STB 312 Date 3-30-04
Pump Tank: 1000 Gallons; PT 27 Date 3-8-04
Pump Make: Goulds Model WE0312MV Serial No.
Nitrification Field: No Fields 1 Square Feet 420 Linear Feet 210
No Lines 3@70' Trench Width 24" Max Trench Bottom Depth 36" Gravel Depth N/A

☑ New System ☐ Repair System Type: I, II, III, IV, V, VI
System Description: LP PANEL
Repair System Description: SAME
Maintenance Agreement Required: ☑ Yes ☐ No


☑ House/Mod. Home No. Bedrooms 3
☐ Mobile Home No. Bathrooms 3
☐ Business No. Employees
☐ Other
☐ Slab ☑ Crawl Space ☐ Basement w/plumbing ☐ Basement wo/plumbing

Water Supply: ☑ Individual ☐ Public ☐ Community

Comments:/Conditions: 1) ROADBED TO BE CLEANED UP AND SMOOTHED.

Comments:/Conditions: Checked tanks & lines 5/19/04 MP
Pressure, elect & alarm 6/4/04 MP

INITIAL SITE SKETCH

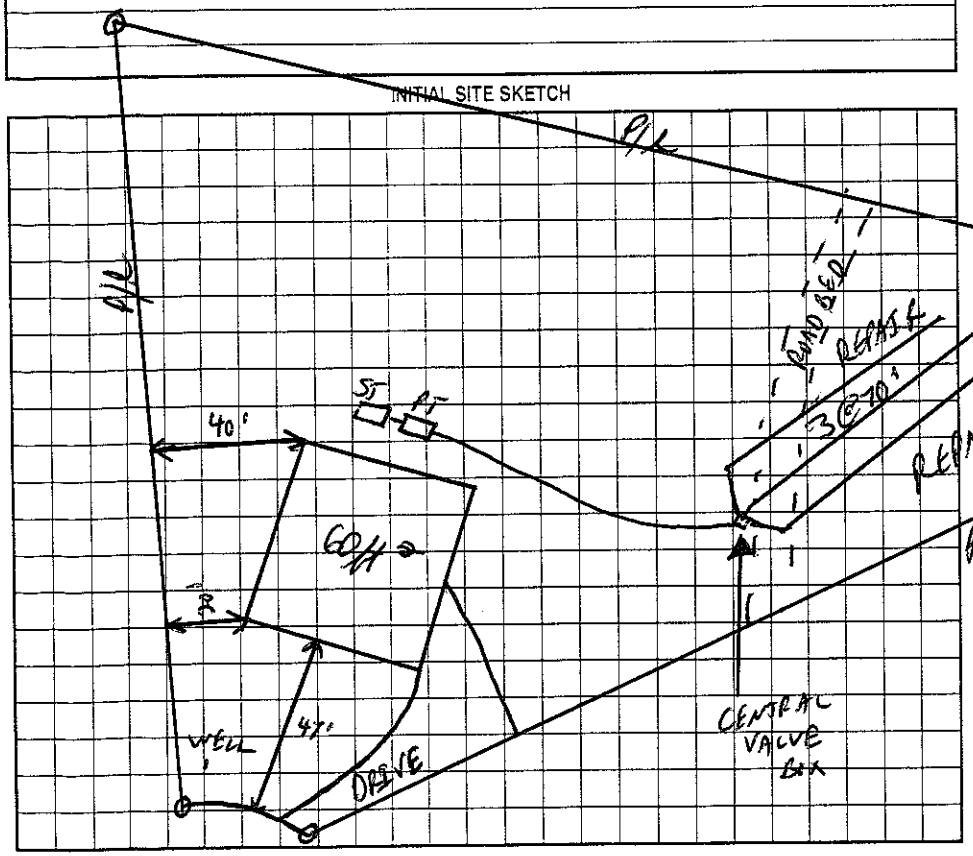

AS BUILT SKETCH

Installed as Drawn

Permit can be suspended or revoked if any false information is supplied toward securing the permit/any unauthorized changes are made to the site/any unauthorized changes are made in the installation of the system. Improvement Permit with plat valid without expiration. Improvement Permit with site plan valid for sixty months. Authorization to Construct is valid for a period equal to that of Improvement Permit – not to exceed sixty months.

Signed: [signature] date 7-26-01

Improvement Permit by: [signature] RS date 6/14/01

Authorization to Construct by: [signature] date 7/9/03

Installed by: R&H

Operation Permit by: [signature] RS date 6/4/04

Existing System Inspection by: date

HEALTH DEPT. COPY: WHITE OWNER COPY (FINAL): YELLOW OWNER COPY (INITIAL): PINK