IREDELL COUNTY HEALTH DEPARTMENT

Statesville Phone TR 3-7271 Mooresville Phone NO 3-1271

PERMIT TO INSTALL SEPTIC TANK

Permit NO. 212 Permit Date 10-3- 1972

Owner Melvin Barnhart Address Harrisburg (Cabarrus Co)

Installed By Earl Scharn Address Concord

Location of Property Sec 9 Lot 56

1100 to 1178 to 1443 Go 1mi


on right.

| Tank | | Capacity | | Length of Lines | | Fixtures | |
|---|---|---|---|---|---|---|---|
| Block | ( ) | 1000 | ( ) | 225' | ( ) | No. of Baths | ( ) |
| Precast | (✓) | 1250 | ( ) | 250' | ( ) | Dishwasher | (no) |
| | | 1500 | ( ) | Other | | Garbage Grdr. | (no) |
| | | Other | | | | Other | |

NOTIFY HEALTH DEPARTMENT AT LEAST EIGHT HOURS BEFORE TANK IS TO BE INSPECTED.

Final Inspection 10-3- 1972 Approved (✓) Disapproved ( )

Remarks

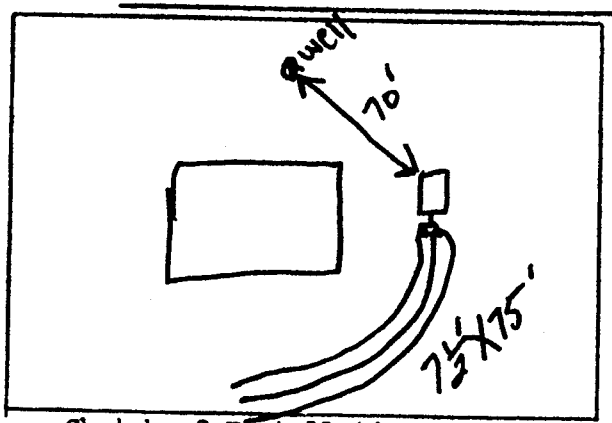


Sketch of Installation

J. C. Moore

Sanitarian