IREDELL COUNTY HEALTH DEPARTMENT

STATESVILLE 704-878-5305 MOORESVILLE 704-664-5281

IMPROVEMENT PERMIT / AUTHORIZATION TO CONSTRUCT / OPERATION PERMIT / EXISTING SYSTEM INSPECTION

PERMIT# Repair PIN# 4627826422 DATE 6/20/05

OWNER OR CONTRACTOR Tony Woodring PHONE: Business 704-619-6405 Home 704 664-4452

ADDRESS 534 Beaten path Rd Mooresville NC 28117

LOCATION BSR, TR Blume, TL Beaten Path on Rt #534

SUBDIVISION CLRT BLOCK / SECTION 9 LOT 55 LOT AREA 0.71 Ac SITE CLASS. PS DESIGN FLOW 360 L.T.A.R. —

Septic Tank: Existing Gallons; STB ____ Date ____

Pump Tank: ____ Gallons; PT ____ Date ____

Pump Make: ____ Model ____ Serial No. ____

Nitrification Field: No Fields ____ Square Feet 585 Linear Feet 65'

No Lines ____ Trench Width 9' Max Trench Bottom Depth ____ Gravel Depth ____

☐ New System ☒ Repair System Type: I, II, III, IV, V, VI

System Description: ____

Repair System Description: 25% Reduct. Bod

Maintenance Agreement Required: ☐ Yes ☒ No

☒ House/Mod. Home No. Bedrooms 3

☐ Mobile Home No. Bathrooms ____

☐ Business No. Employees ____

☐ Other ____


☐ Slab ☒ Crawl Space ☐ Basement w/plumbing ☐ Basement wo/plumbing

Water Supply: ☒ Individual ☐ Public ☐ Community


Comments:/Conditions:

Comments:/Conditions:

INITIAL SITE SKETCH

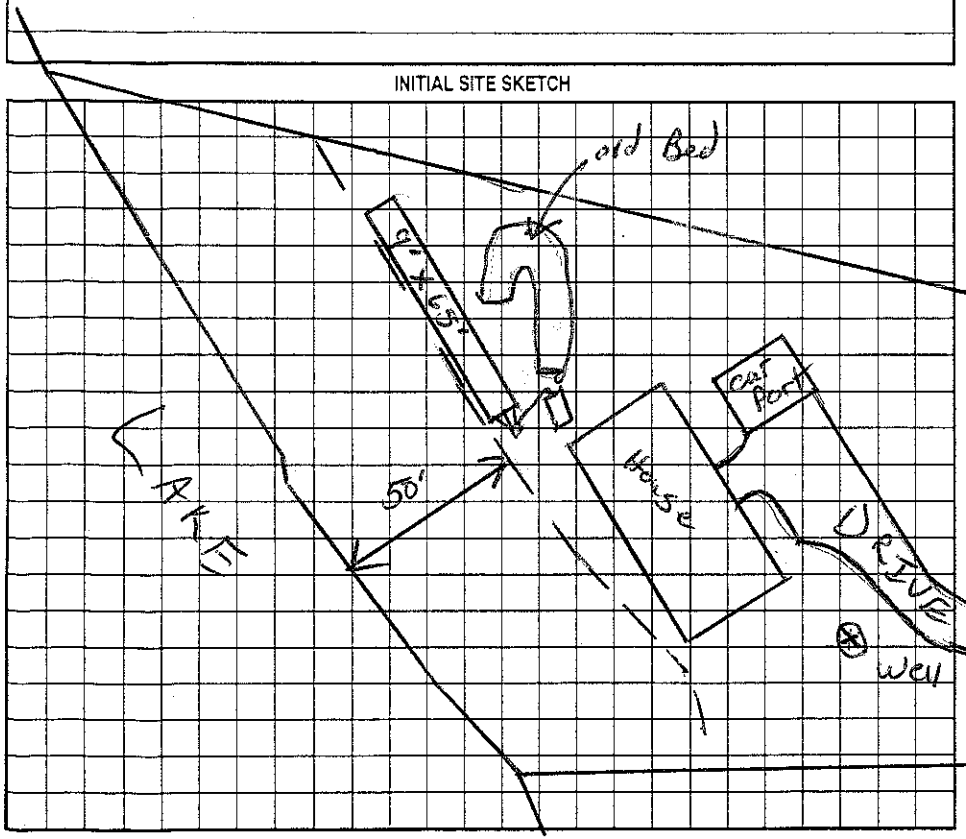

AS BUILT SKETCH

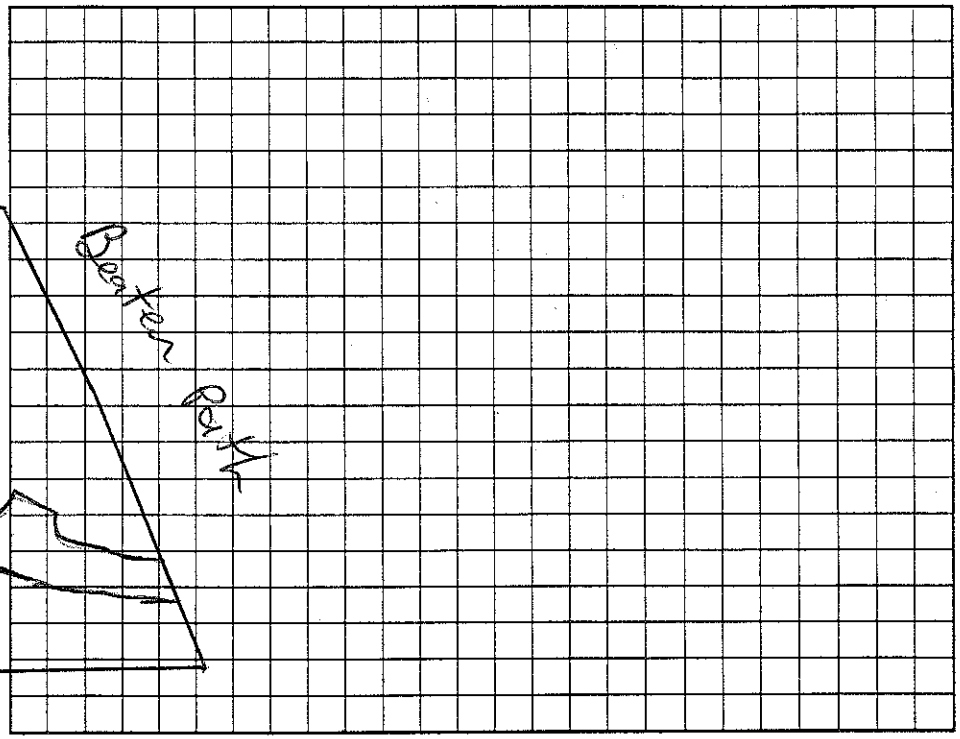

Permit can be suspended or revoked if any false information is supplied toward securing the permit/any unauthorized changes are made to the site/any unauthorized changes are made in the installation of the system. Improvement Permit with plat valid without expiration. Improvement Permit with site plan valid for sixty months. Authorization to Construct is valid for a period equal to that of Improvement Permit – not to exceed sixty months.

Signed: Stephanie Woodring date 6/22/05 Installed by: JW Ammons

Improvement Permit by: RS date 6/20/05 Operation Permit by: Wesley Sparks R.S. date 7/19/05

Authorization to Construct by: RS date 6/20/05 Existing System Inspection by: ____ date ____

HEALTH DEPT COPY: WHITE OWNER COPY (FINAL): YELLOW OWNER COPY (INITIAL): PINK