IREDELL COUNTY HEALTH DEPARTMENT

→ AUTHORIZATION TO CONSTRUCT 4627826638

STATESVILLE 704-878-5305 MOORESVILLE 704-664-5281

IMPROVEMENT PERMIT / ~~CERTIFICATE OF COMPLETION~~ / OPERATION PERMIT / EXISTING SYSTEM INSPECTION

PROPERTY DESCRIPTION NO. 24347 DATE 8/20/96 TAX MAP NO. 2L-A-13 pt of Watershed: ☑ Yes ☐ No

OWNER OR CONTRACTOR WALTER (MALCOLM) CLARK PHONE: Business 875-1528 Home

ADDRESS PO BOX 1380 HUNTERSVILLE 28078

LOCATION BRAWLEY SCHOOL RD - TR BLUME RD - TL BEATEN PATH LOT ON LEFT

SUBDIVISION SHAVENDERS BLUFF BLOCK / SECTION LOT 49 LOT AREA .6912 AC SITE CLASS PS DESIGN FLOW 480GPD L.T.A.R. .36GPD/FT²

Septic Tank: 1000 Gallons; STB 794 Date 12/4/96

Pump Tank: Gallons; PT Date

Pump Make: Model Serial No.

Nitrification Field: No Fields 1 Square Feet 1200 Linear Feet 400

No Lines 3 Trench Width 36" Max Trench Bottom Depth 36" Gravel Depth N/A

☑ New System ☐ Repair System Type: I, II, (III), IV, V, VI

System Description: GRAVITY CHAMBERED

Repair System Description: GRAVITY PANEL

Maintenance Agreement Required: ☐ Yes ☑ No

☑ House/Mod. Home ☐ Mobile Home ☐ Business ☐ Other

No. Bedrooms 4 No. Bathrooms 3 No. Employees


☐ Slab ☑ Crawl Space ☐ Basement w/plumbing ☐ Basement wo/plumbing

Water Supply: ☑ Individual ☐ Community ☐ Public

Comments:

Comments:

INITIAL SITE SKETCH 206' 1"=40'

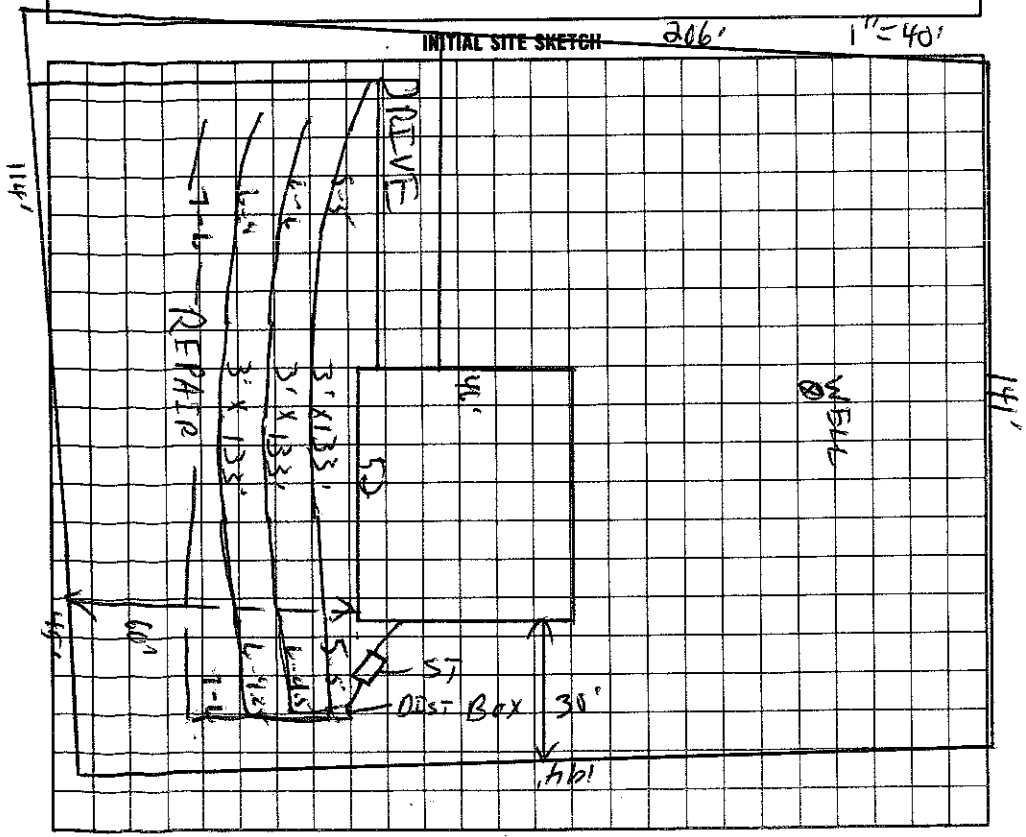

AS BUILT SKETCH

I understand that this permit can be suspended or revoked if any false information is supplied toward securing the permit/any unauthorized changes are made to the site/any unauthorized changes are made in the installation of the system.

Signed: M. A. Clark

Improvement Permit by: C. B. Thomas EHSI date 8/20/96

~~Existing System Inspection~~ AUTHORIZATION TO CONSTRUCT by: C. B. Thomas EHSI date 8/20/96

Installed by: Larry Beam

Certificate of Completion by: Wesley Spencer RS. date 2/26/97

Operation Permit by: Wesley Spencer RS. date 2/26/97

HEALTH DEPT. COPY: WHITE INSPECTION COPY (FINAL): GREEN OWNER COPY (FINAL): YELLOW INSPECTION COPY (INITIAL): PINK OWNER COPY (INITIAL): GOLD