# IREDELL COUNTY HEALTH DEPARTMENT

4627827697 (1:30)

STATESVILLE 704-878-5305 MOORESVILLE 704-664-5281

## IMPROVEMENT PERMIT / CERTIFICATE OF COMPLETION / OPERATION PERMIT / EXISTING SYSTEM INSPECTION

PROPERTY DESCRIPTION NO. 26066 DATE 1/28/97 TAX MAP NO.

OWNER OR CONTRACTOR Peyton Tucker

ADDRESS PO Box 1061 Cornelius NC 28031 PHONE: Business 892-0451 Home

Watershed: [X] Yes ☐ No

LOCATION Beaten Path - 1100 TR Blume (R) on Beaten Path. (R) to 15th lot on (L)

SUBDIVISION Showerdens Bluff BLOCK / SECTION LOT 50 LOT AREA .77AC SITE CLASS. PS DESIGN FLOW 360 L.T.A.R. .3

Septic Tank: 1000 Gallons; STB 744 Date 8/12/97

Pump Tank: Gallons; PT Date

Pump Make: Model Serial No.

Nitrification Field: No Fields 1 Square Feet 900 Linear Feet *300

No Lines 3 Trench Width 36" Max Trench Bottom Depth 30" Gravel Depth SAND

[X] New System ☐ Repair System Type: I, II, (III), IV, V, VI

System Description: *CH PLASTK

Repair System Description: SAME

Maintenance Agreement Required: ☐ Yes ☐ No

[X] House/Mod. Home ☐ Mobile Home ☐ Business ☐ Other

No. Bedrooms 3 No. Bathrooms 2.5 No. Employees


☐ Slab [X] Crawl Space ☐ Basement w/plumbing ☐ Basement wo/plumbing

Water Supply: [X] Individual ☐ Community ☐ Public


Comments: Lines installed on contour in manner shown here. Speed Levelers in Dist. Box required.

Comments:

INITIAL SITE SKETCH

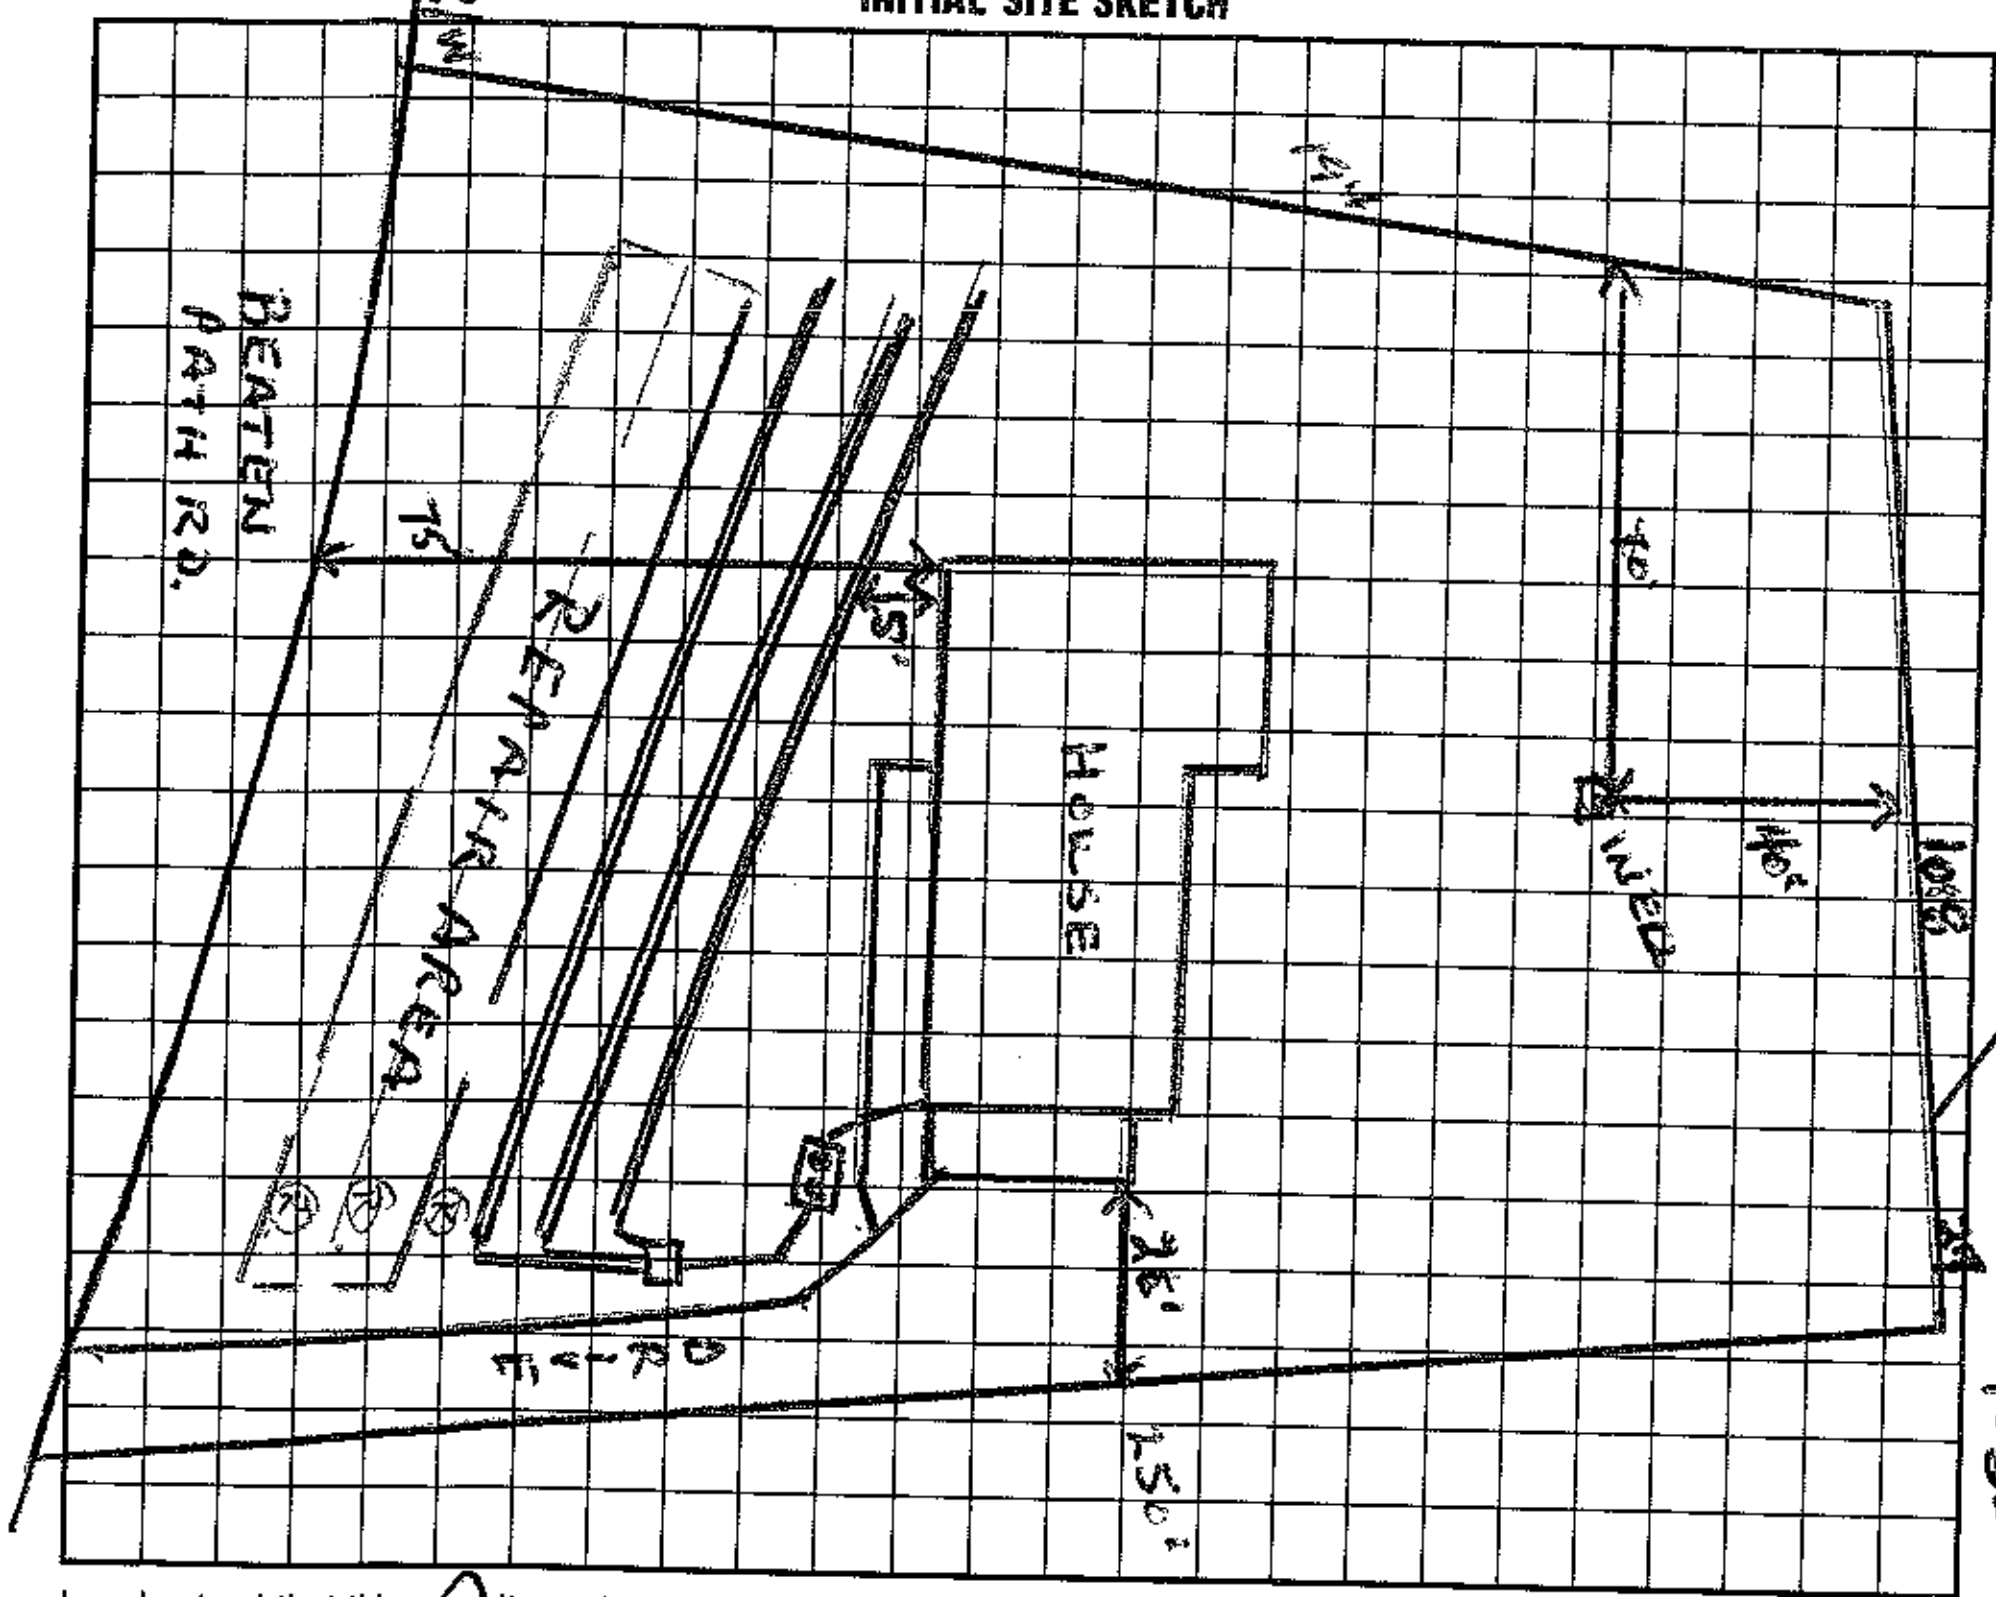


AS BUILT SKETCH

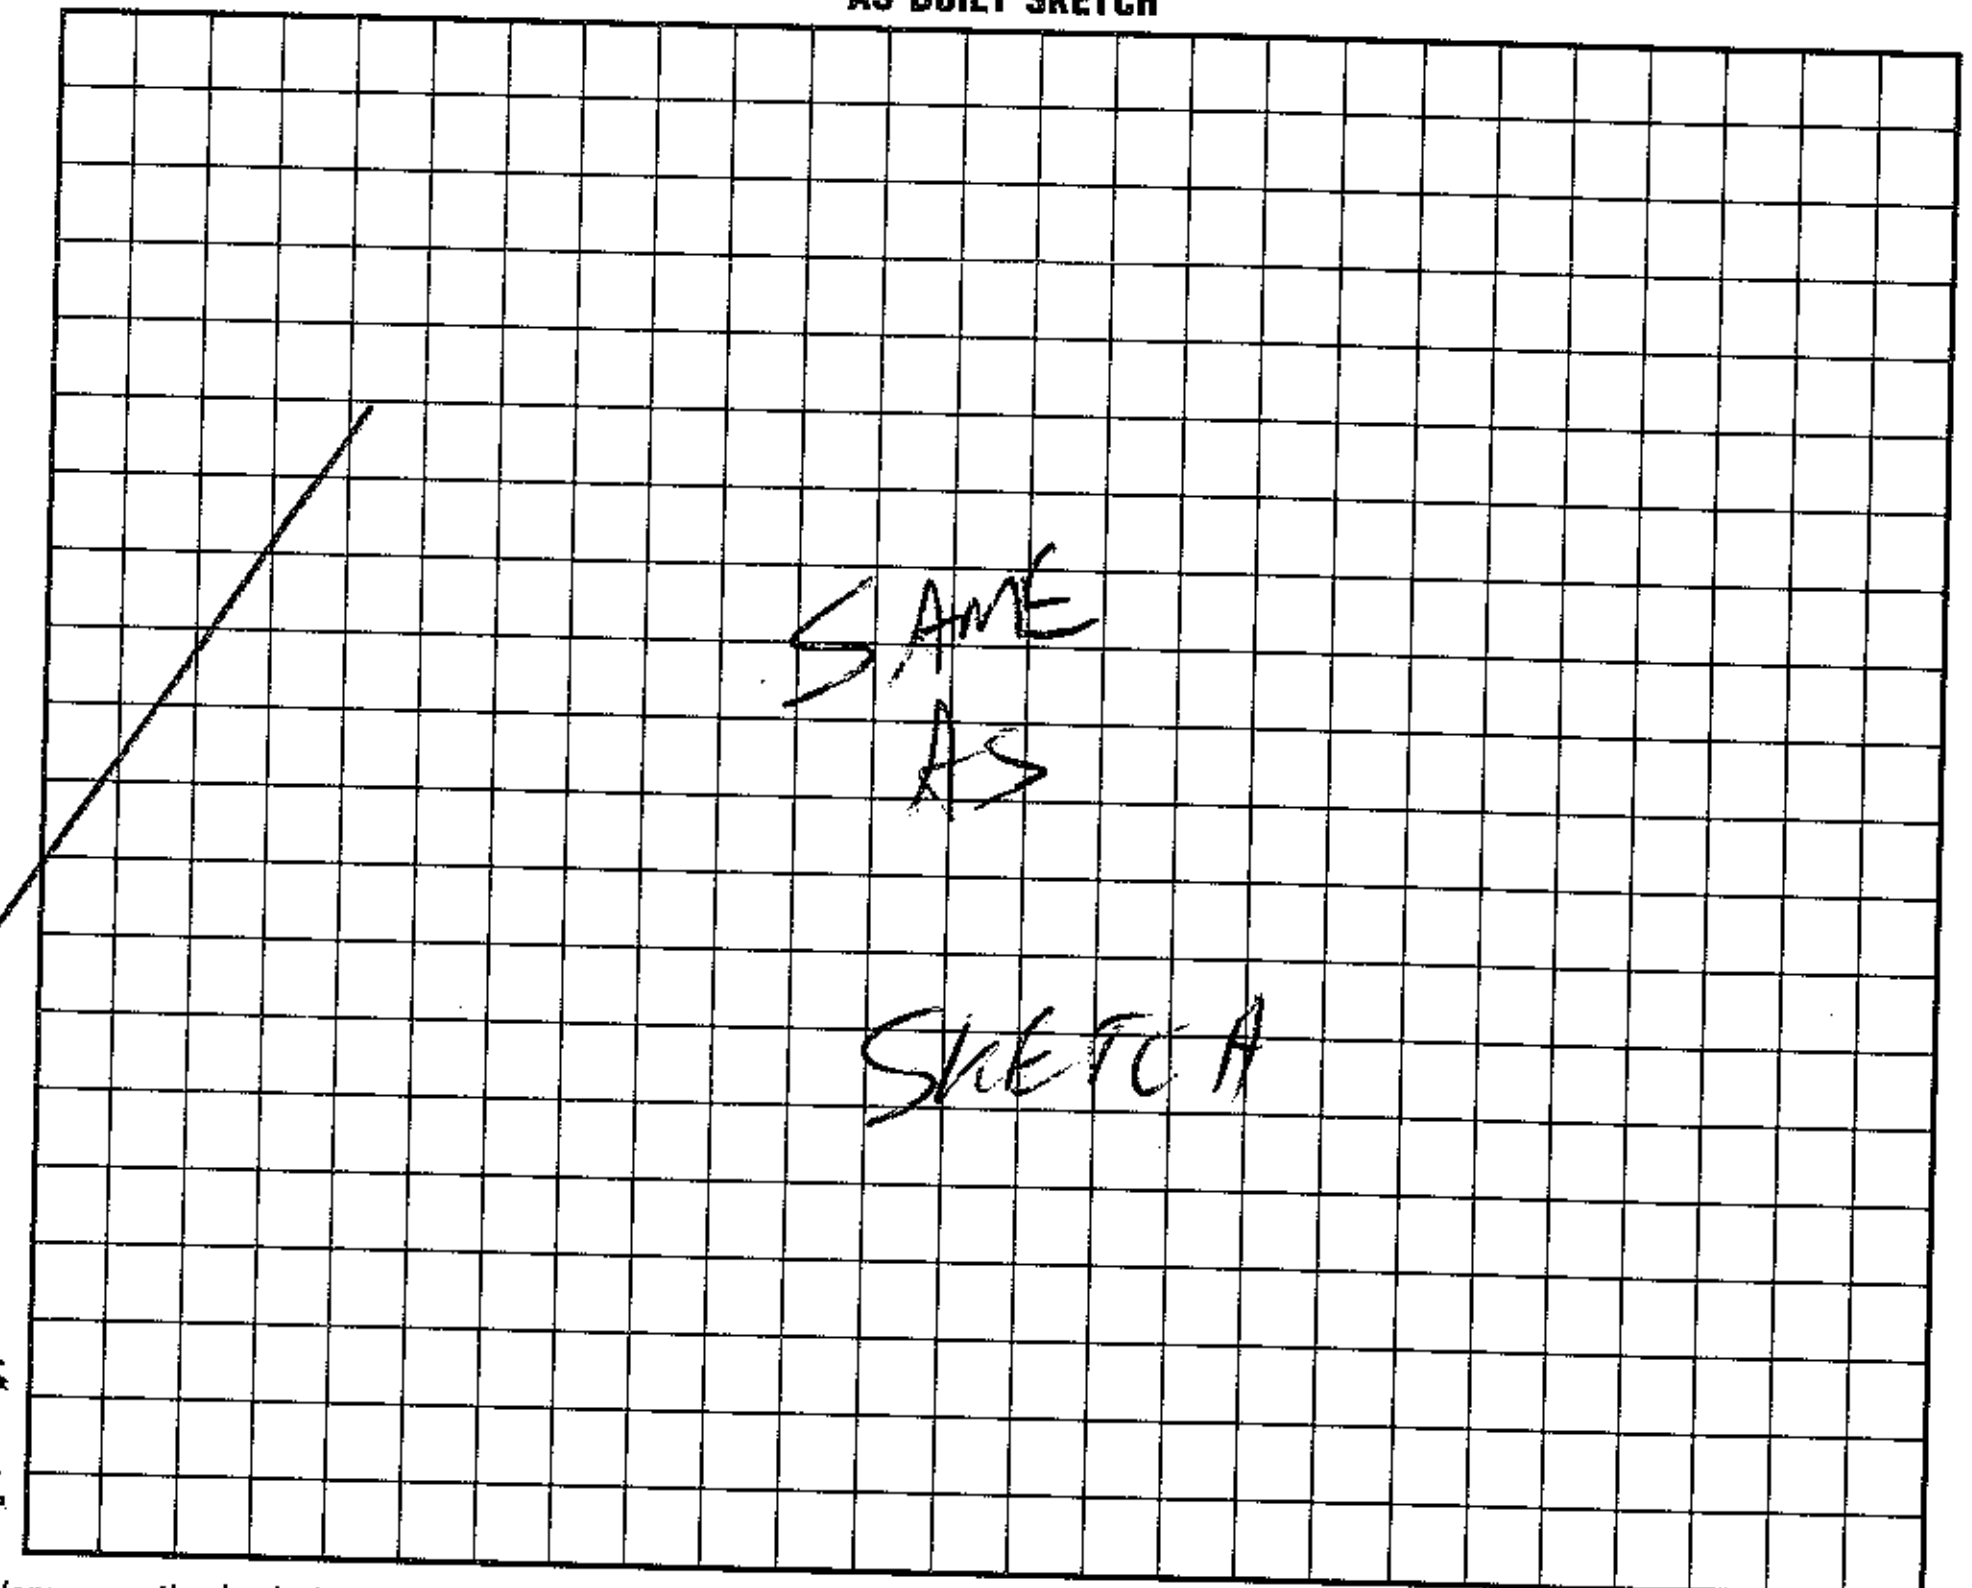


I understand that this permit can be suspended or revoked if any false information is supplied toward securing the permit/any unauthorized changes are made to the site/any unauthorized changes are made in the installation of the system. Improvement Permit is valid for 60 months from date of issuance.

Signed: x Peyton Tucker

Improvement Permit by: Wesley Sparks RS date 2/5/97

Existing System Inspection by: Wesley Sparks R.S. date 2/5/97

Installed by: Ammons

Certificate of Completion by: date

Operation Permit by: C. Brady Freeman RS date 10/24/97

HEALTH DEPT. COPY: WHITE INSPECTION COPY (FINAL): GREEN OWNER COPY (FINAL): YELLOW INSPECTION COPY (INITIAL): PINK OWNER COPY (INITIAL): GOLD