IREDELL COUNTY HEALTH DEPARTMENT

Authorization to Construct 4627827914

STATESVILLE 704-878-5305 MOORESVILLE 704-664-5281

IMPROVEMENT PERMIT / ~~CERTIFICATE OF COMPLETION~~ / OPERATION PERMIT / EXISTING SYSTEM INSPECTION

PROPERTY DESCRIPTION NO. 24239 DATE 8/13/96 TAX MAP NO. 2L 4B 46

OWNER OR CONTRACTOR Danny Ashcraft PHONE: Business Watershed: [X] Yes [ ] No

ADDRESS 20918 Highland Forest Dr. Cornelius, NC. 28031 Home 896-8302

LOCATION Beaton Path - Brawley TR Blume TL Beaton Path TL Beaton Path ~ .3 mile on (L)

SUBDIVISION Shores Lens Bluff BLOCK / SECTION LOT #6 LOT AREA .73 AC SITE CLASS. PS DESIGN FLOW 480 L.T.A.R. .35

Septic Tank: 1000 Gallons; STB 794 Date 6/11/96

Pump Tank: Gallons; PT Date

Pump Make: Model Serial No.

Nitrification Field: No Fields 1 Square Feet 1391 Linear Feet 480

No Lines 8 Trench Width 36" Max Trench Bottom Depth 36" Gravel Depth 12"

[X] New System [ ] Repair System Type: I, II, III, IV, V, VI

System Description: GRAV - CONV.

Repair System Description: GRAV - CH.

Maintenance Agreement Required: [ ] Yes [X] No

[X] House/Mod. Home No. Bedrooms 4

[ ] Mobile Home No. Bathrooms 3

[ ] Business No. Employees

[ ] Other


[ ] Slab [X] Crawl Space [ ] Basement w/plumbing [ ] Basement wo/plumbing

Water Supply: [X] Individual [ ] Community [ ] Public


Comments: 2 FLOW DIVIDER SET AS DRAWN
Follow slope contour with drain lines

Comments:

INITIAL SITE SKETCH

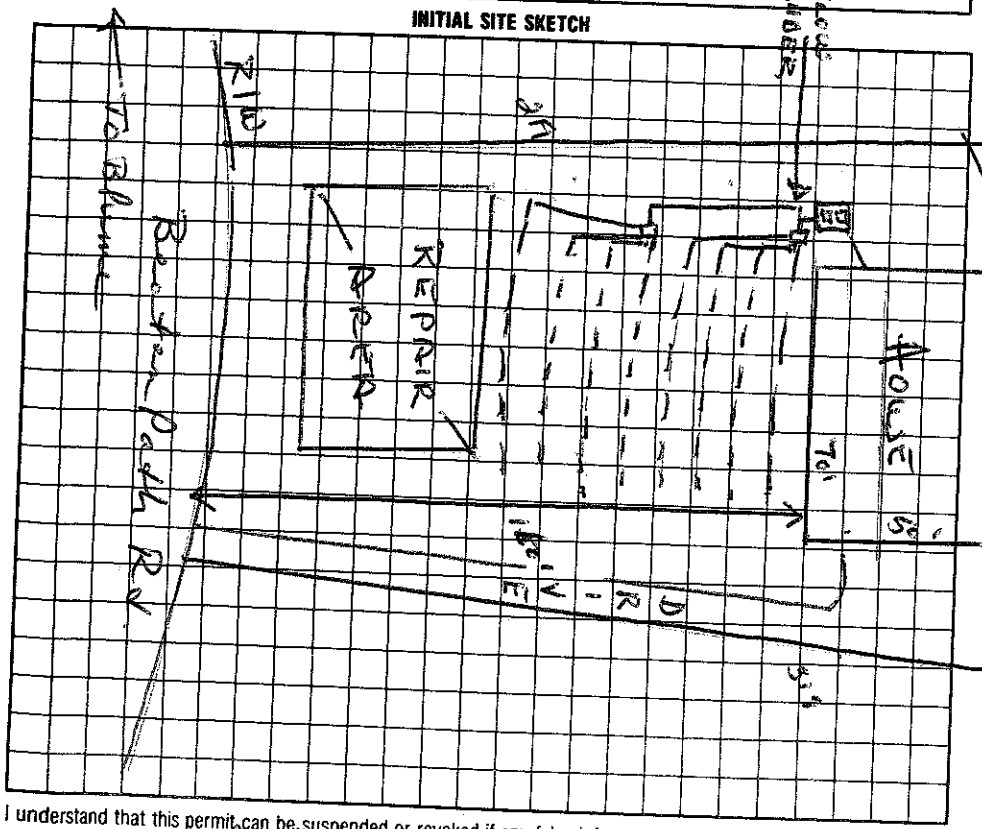

AS BUILT SKETCH

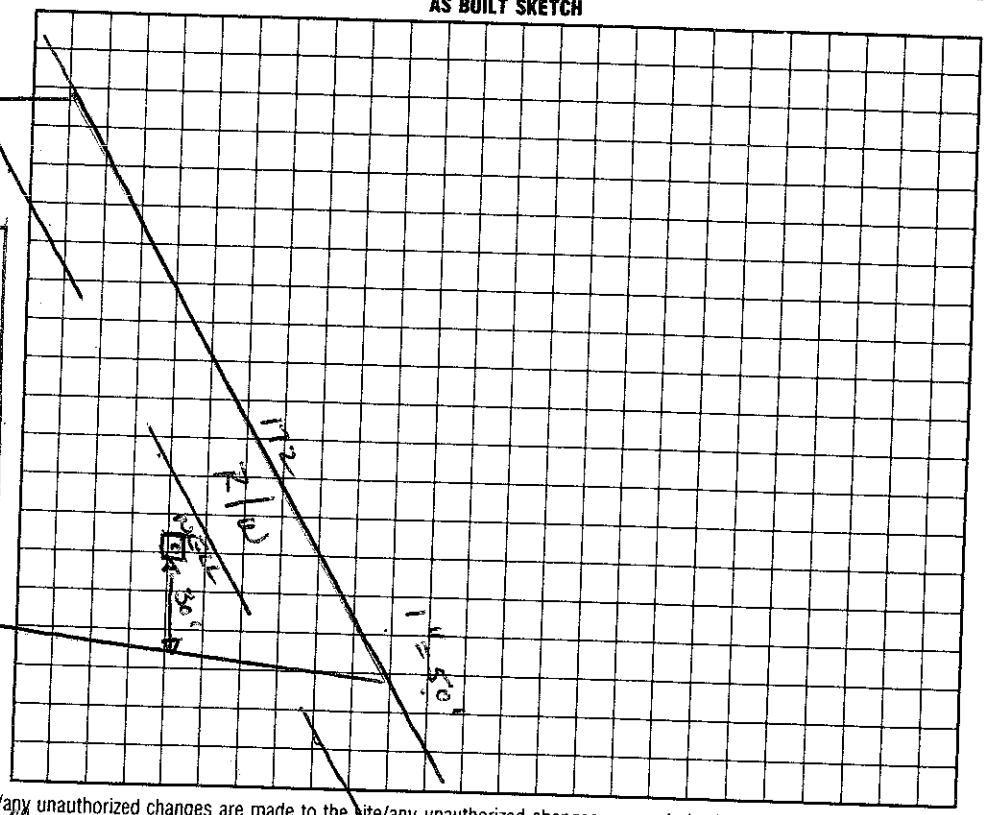

I understand that this permit can be suspended or revoked if any false information is supplied toward securing the permit/any unauthorized changes are made to the site/any unauthorized changes are made in the installation of the system.

Signed: Danny L Ashcraft

Authorization to construct valid 60 months.

Improvement Permit by: Wesley Sparks RS date 8/13/96

Existing System Inspection by: Wesley Sparks RS. date 8/13/96

Installed by: Curt Dunning

Certificate of Completion by: Wesley Sparks RS date 8/13/98

Operation Permit by: Wesley Sparks RS. date 8/13/98

HEALTH DEPT. COPY: WHITE INSPECTION COPY (FINAL): GREEN OWNER COPY (FINAL): YELLOW INSPECTION COPY (INITIAL): PINK OWNER COPY (INITIAL): GOLD