IREDELL COUNTY HEALTH DEPARTMENT

STATESVILLE 704-878-5305 MOORESVILLE 704-664-5

IMPROVEMENT PERMIT / CERTIFICATE OF COMPLETION / OPERATION PERMIT / EXISTING SYSTEM I... SECTION

PROPERTY DESCRIPTION NO. 24176 DATE June 14,96 TAX MAP NO. 2L 4A 64/65 4627-83-1485 Watershed: [ ]

OWNER OR CONTRACTOR Joe Martin PHONE: Business _____ Home _____

ADDRESS 1233 Big Horse DR, Charlotte [ ] No

LOCATION Brawley Sch RD TR Blume TL Beaten Path (twice) 1/4 mile on Right

SUBDIVISION Crestcrest BLOCK / SECTION 9 LOT 64/65 LOT AREA 1.84Ac SITE CLASS. PS DESIGN FLOW 480gpd L.T.A.R. 1.4

Septic Tank: Existing Gallons; STB _____ Date _____

Pump Tank: _____ Gallons; PT _____ Date _____

Pump Make: _____ Model _____ Serial No. _____

Nitrification Field: No Fields 1 Square Feet Ext 300 Linear Feet Ext + 160

No Lines 5 (total) Trench Width 36" Max Trench Bottom Depth 24-36" Gravel Depth 12"

[ ] New System [x] Repair System Type: I, II, III, IV, V, VI

System Description: 9pac conventional

Repair System Description: LP panel blocks

Maintenance Agreement Required: [ ] Yes [x] No

[x] House/Mod. Home No. Bedrooms 4

[ ] Mobile Home No. Bathrooms 4

[ ] Business No. Employees ____

[ ] Other _____


[ ] Slab [x] Crawl Space [ ] Basement w/plumbing [ ] Basement wo/plumbing

Water Supply: [x] Individual [ ] Community [ ] Public


Comments: Addition to house of bedroom + great room

Comments:

INITIAL SITE SKETCH

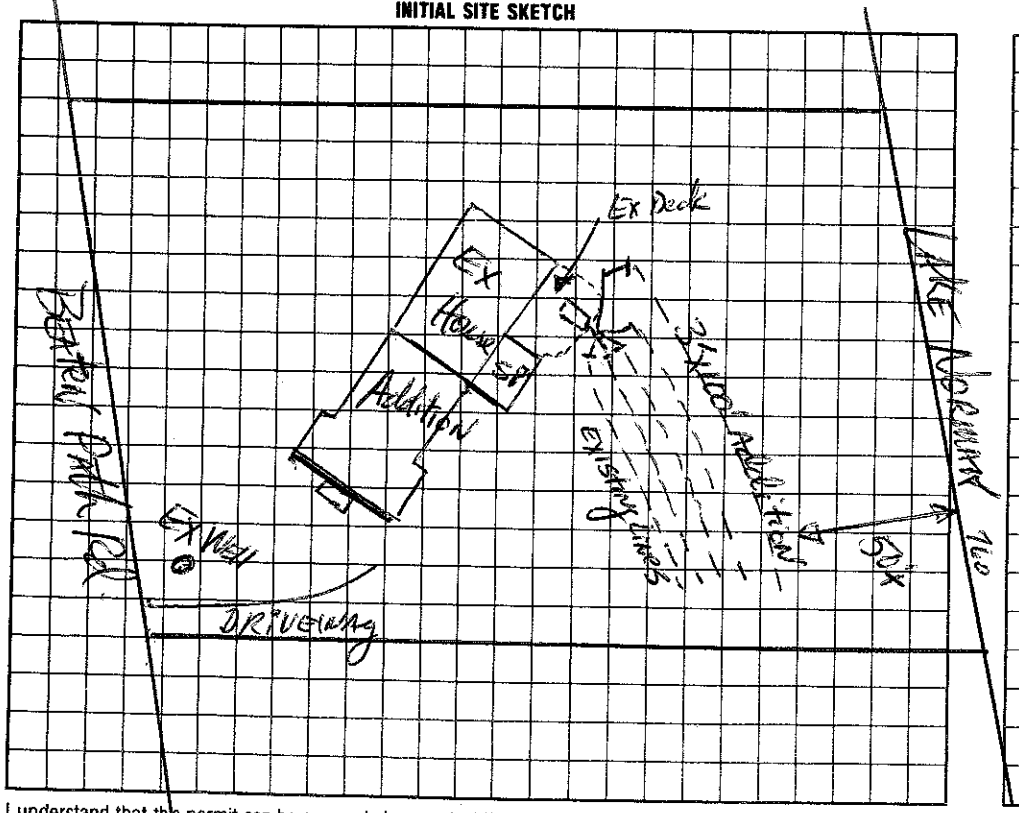

AS BUILT SKETCH

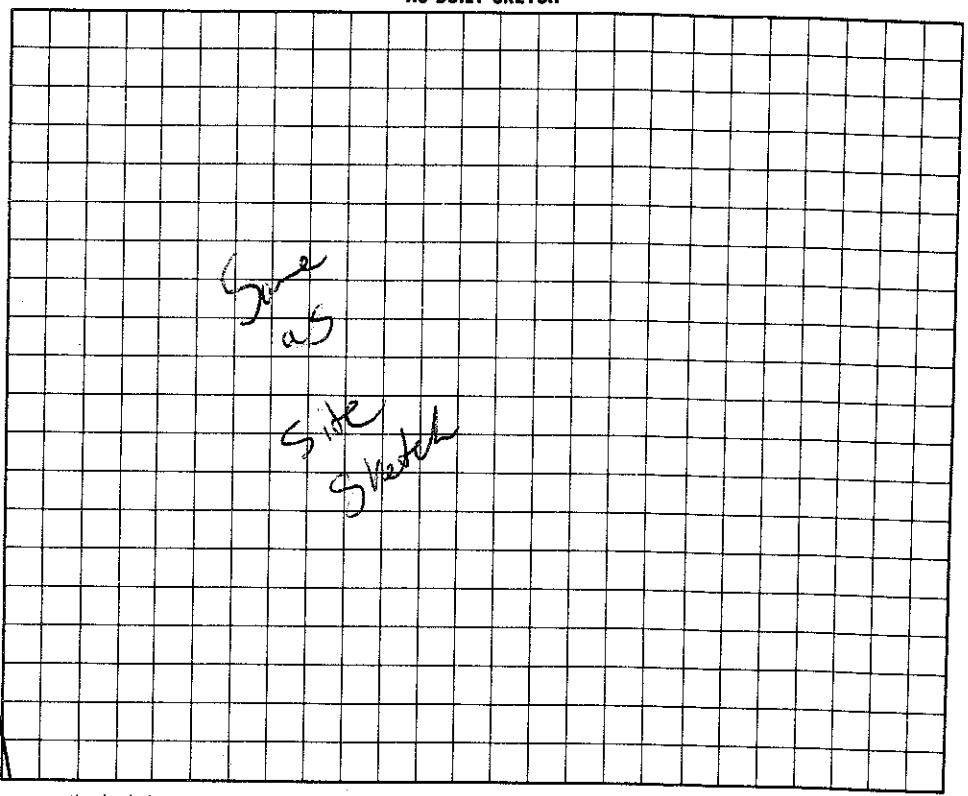

I understand that this permit can be suspended or revoked if any false information is supplied toward securing the permit/any unauthorized changes are made to the site/any unauthorized changes are made in the installation of the system.

Signed: Cynthia Rozeman

Improvement Permit by: Harold Hawkins RS date 6-14-96

Existing System Inspection by: Construction Authorized Harold Hawkins RS date 6-14-96

Installed by: LITTLE HAWKINS

Certificate of Completion by: _____ date _____

Operation Permit by: C. Ruby date 4/25/97

HEALTH DEPT. COPY: WHITE INSPECTION COPY (FINAL): GREEN OWNER COPY (FINAL): YELLOW INSPECTION COPY (INITIAL): PINK OWNER COPY (INITIAL): GOLD