# IREDELL COUNTY HEALTH DEPARTMENT

Dent' section to Construct 4627833796

STATESVILLE 704-878-5305 MOORESVILLE 704-664-5281

## IMPROVEMENT PERMIT / ~~CERTIFICATE OF COMPLETION~~ / OPERATION PERMIT / EXISTING SYSTEM INSPECTION

PROPERTY DESCRIPTION NO. 24813 DATE 9/10/96 TAX MAP NO. 2L 4A 41 Watershed: X Yes ☐ No

OWNER OR CONTRACTOR Bryce Hagewood PHONE: Business Home 598-0589

ADDRESS 7424 Pondgate End Ln. Chas. NC. 28213

LOCATION Benton Path Rd - 1100 TR Blume TL Benton Path (L) 4th on (L) past Rosbury Circle

SUBDIVISION Shoreacres Bluff BLOCK / SECTION 1 LOT 41 LOT AREA .98 SITE CLASS. PS DESIGN FLOW 480 L.T.A.R. .35

Septic Tank: 1000 Gallons; STB 774 Date 12/17/96

Pump Tank: ____ Gallons; PT ____ Date ____

Pump Make: ____ Model ____ Serial No. ____

Nitrification Field: No Fields 1 Square Feet 1371 Linear Feet 345

No Lines 6 Trench Width 36" Max Trench Bottom Depth 36" Gravel Depth SAND

X New System ☐ Repair System Type: I, II, (III) IV, V, VI

System Description: Ch PLASTIC

Repair System Description: SAME

Maintenance Agreement Required: ☐ Yes X No

X House/Mod. Home No. Bedrooms 4

☐ Mobile Home No. Bathrooms 3

☐ Business No. Employees ____

☐ Other ____


☐ Slab X Crawl Space ☐ Basement w/plumbing ☐ Basement wo/plumbing

Water Supply: X Individual ☐ Community ☐ Public


Comments: House corner 100' from road R/W
Sand backfill around louvers on Ch. Plastic sections.

Comments:

**INITIAL SITE SKETCH**

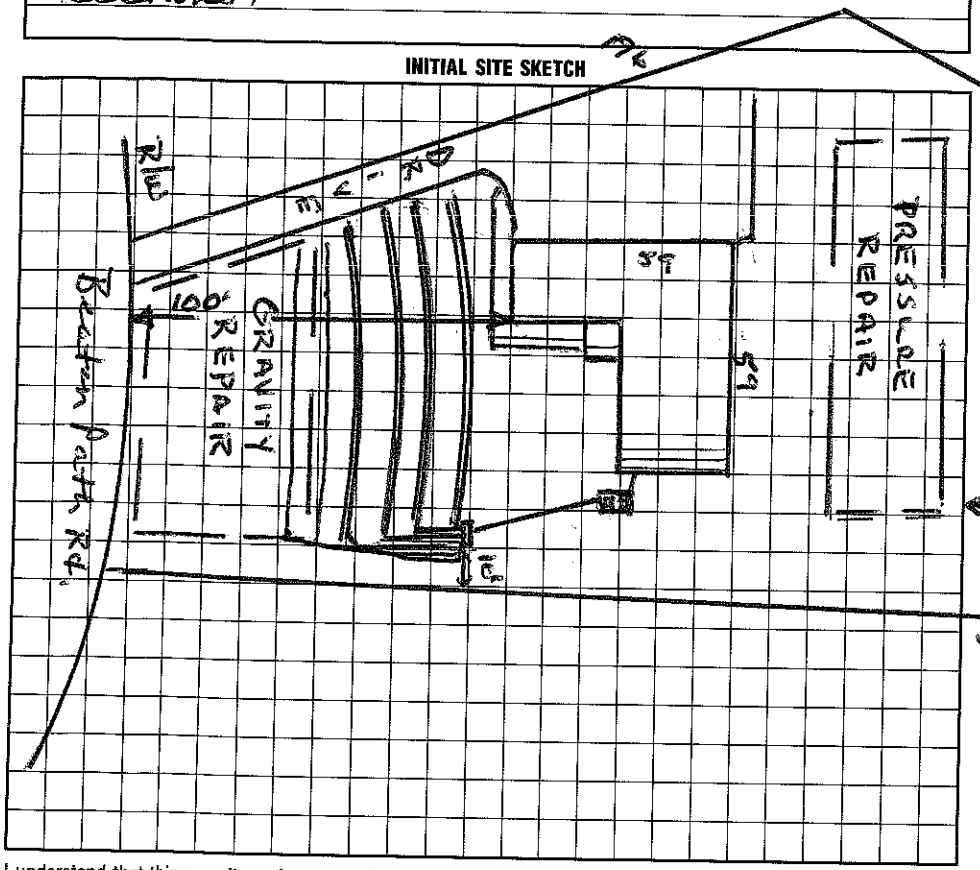


**AS BUILT SKETCH**

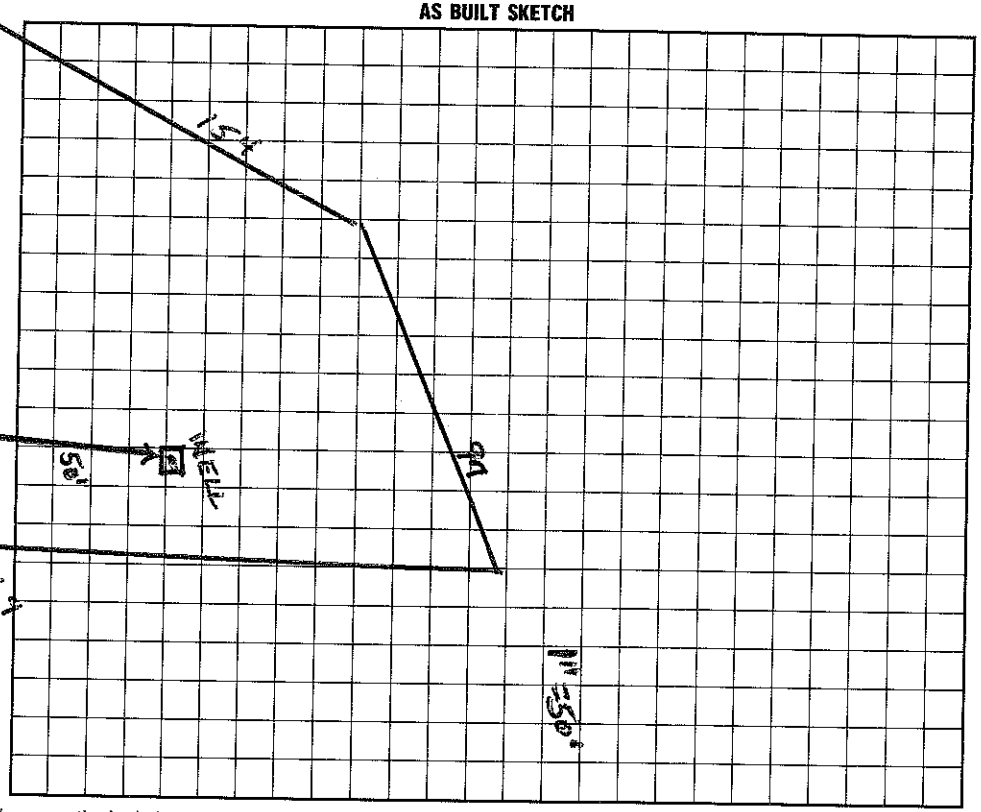


I understand that this permit can be suspended or revoked if any false information is supplied toward securing the permit/any unauthorized changes are made to the site/any unauthorized changes are made in the installation of the system.

Signed: X Dent Iverson Section to Construct valid for 60 months.

Improvement Permit by: Wesley Sparks RS. date 9/10/96

Existing System Inspection by: Dent Wesley Sparks RS. date 9/16/96

Installed by: Dent Dunning

Certificate of Completion by: Wesley Sparks RS. date 4/11/97

Operation Permit by: Wesley Sparks RS. date 4/11/97

HEALTH DEPT. COPY: WHITE INSPECTION COPY (FINAL): GREEN OWNER COPY (FINAL): YELLOW INSPECTION COPY (INITIAL): PINK OWNER COPY (INITIAL): GOLD