IREDELL COUNTY HEALTH DEPARTMENT

Statesville Office (704) 878-5305 MP Mooresville Office (704) 660-3625 PERMIT # REPAIR

IMPROVEMENT PERMIT / AUTHORIZATION TO CONSTRUCT / OPERATION PERMIT / EXISTING SYSTEM

PIN # 4627-83-5009 21023 1

APPLICANT: BECKY BOAN APPLICANT ADDRESS: 504 BEATEN PATH RD.

SITE ADDRESS: SAME PHONE: 980-721-4312 ALT. PHONE:

SITE DIRECTIONS: RSR, TR BLUME RD, TL BEATEN PATH, ON R

SUBDIVISION: CLET SECTION: 9 LOT # 61 LOT AREA: DESIGN FLOW: 480 L.T.A.R.:

Septic Tank 1000 (gal) STB 760 Date 4-18

Pump Tank (gal) PT Date

Pump Make Model Serial #

Nitrification Fields EXISTING #Lines Linear Ft:

Trench Width Max. Trench Bottom Depth Gravel Depth

☐ New System ☒ Repair ☐ Expansion System Type: I (II) III IV V VI

System Description:

Repair System Description: NEW TANK

Maintenance Agreement Required: ☐ YES ☒ NO

☒ GRAVITY ☐ PRESSURE

☒ Residence No. Bedrooms 4

☐ Business No. Persons

☐ Other No. Employees


☐ Slab ☐ Crawl Space

☐ Basement w/plumbing ☐ Basement w/o plumbing


Water Supply: ☒ Private ☐ Public ☐ Community

Comments / Conditions:

INITIAL SITE SKETCH

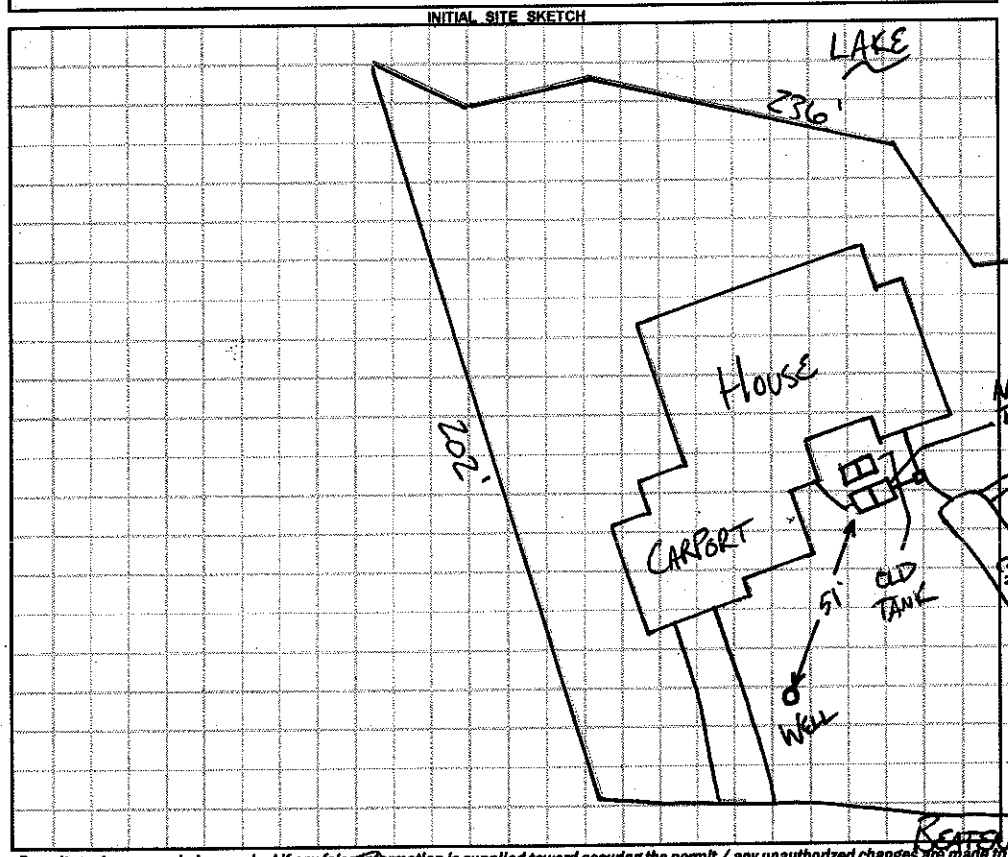

AS BUILT SKETCH

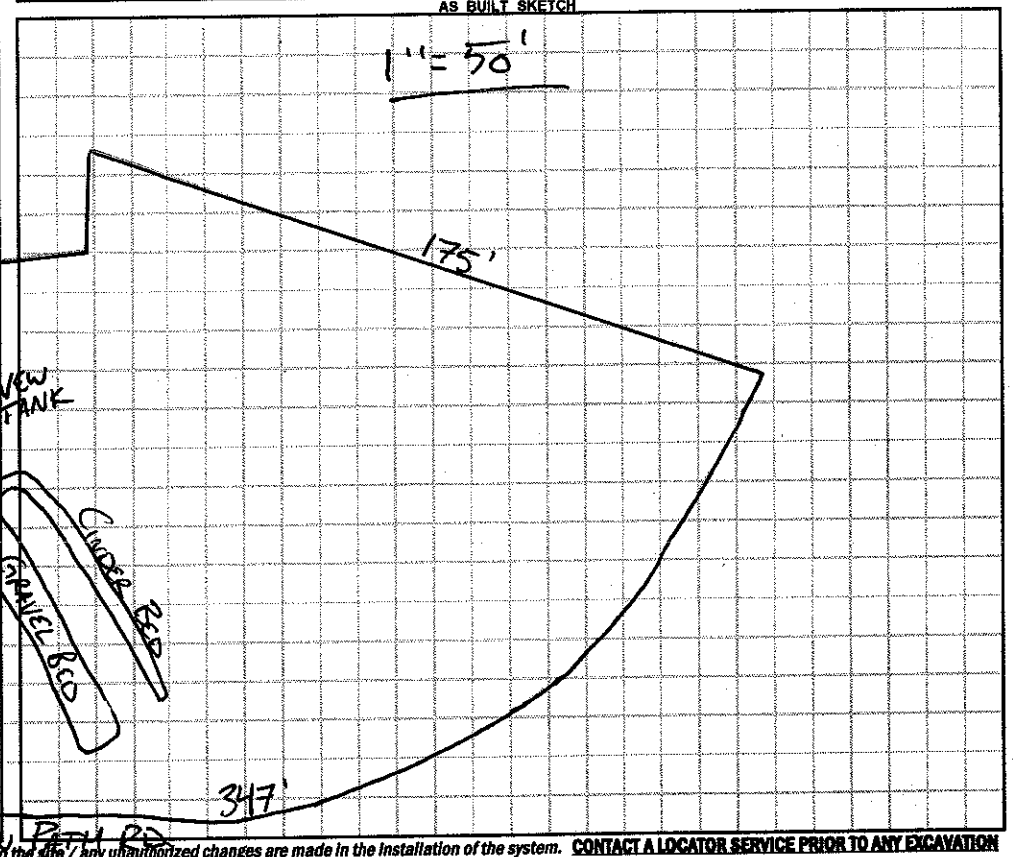

Permit can be suspended or revoked if any false information is supplied toward securing the permit / any unauthorized changes are made to the site / any unauthorized changes are made in the installation of the system. **CONTACT A LOCATOR SERVICE PRIOR TO ANY EXCAVATION**

☐ **IMPROVEMENT PERMIT** *with plat valid without expiration.* ☐ **IMPROVEMENT PERMIT** *with site plan valid for 60 mos.* ☒ **AUTHORIZATION TO CONSTRUCT** *valid for period equal to IMPROVEMENT PERMIT--not to exceed 60 mo.*

Owner / Applicant Signature: Rebecca L Boan Date: 5-6-15 Installed by: JERRY LENTZ

IMPROVEMENT PERMIT by: BA Date: 5-4-15 OPERATION PERMIT by: BA Date: 5-4-15

AUTHORIZATION TO CONSTRUCT by: BA Date: 5-4-15 Existing System Inspected by: Date:

Health Dept. Copy - WHITE Applicant (Final Approval) - YELLOW Applicant (Conditional Approval) - PINK