IREDELL COUNTY HEALTH DEPARTMENT

STATESVILLE 704-878-5305 130.00 Paid MOORESVILLE 704-664-5281 11:00

IMPROVEMENT PERMIT / AUTHORIZATION TO CONSTRUCT / OPERATION PERMIT / EXISTING SYSTEM INSPECTION

PERMIT# 12946 8 PIN# 4627 83 5588 DATE 8/5/05

OWNER OR CONTRACTOR Thomas L + Pam C May / Christopher Palmer PHONE: Business Home 704-660-0674

ADDRESS 493 Beaten Path Rd. Mooresville, NC. 28117

LOCATION Beaten Path Rd, on (L)

SUBDIVISION Greenbriar Bluff BLOCK / SECTION 1 LOT 43 LOT AREA .91 SITE CLASS PS DESIGN FLOW 480 L.T.A.R. .3

Septic Tank: 1000 Gallons; STB 794 Date 6-10-06
Pump Tank: 1000 Gallons; PT 283 Date 11-13-06
Pump Make: Cavins Model WE032 Serial No.
Nitrification Field: No Fields 1 Square Feet 1200 Linear Feet 400
No Lines 4@100' Trench Width 3' Max Trench Bottom Depth 3' Gravel Depth NA

[X] New System [ ] Repair System Type: I, II, III, IV, V, VI
System Description: Pres May → 25% Reduced
Repair System Description: Same Type
Maintenance Agreement Required: [ ] Yes [X] No

[X] House/Mod. Home No. Bedrooms 4
[ ] Mobile Home No. Bathrooms 4
[ ] Business No. Employees
[ ] Other
[ ] Slab [X] Crawl Space [ ] Basement w/plumbing [ ] Basement wo/plumbing


Water Supply: [X] Individual [ ] Public [ ] Community

Comments:/Conditions: House will be 54' From Front and is appox. 65' Deep. Initial and Repair Areas will be Switched. Tanks will move behind House.


Comments:/Conditions: Installed EZ Flow AS Drawn. 12/20/06

(1" = 50')

INITIAL SITE SKETCH

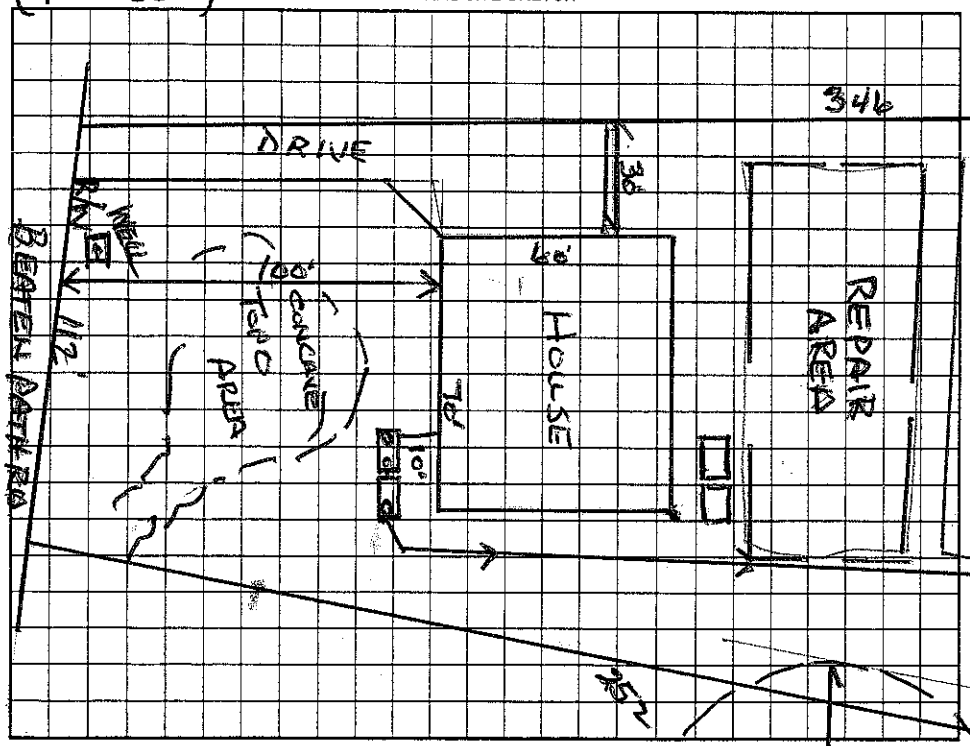

AS BUILT SKETCH

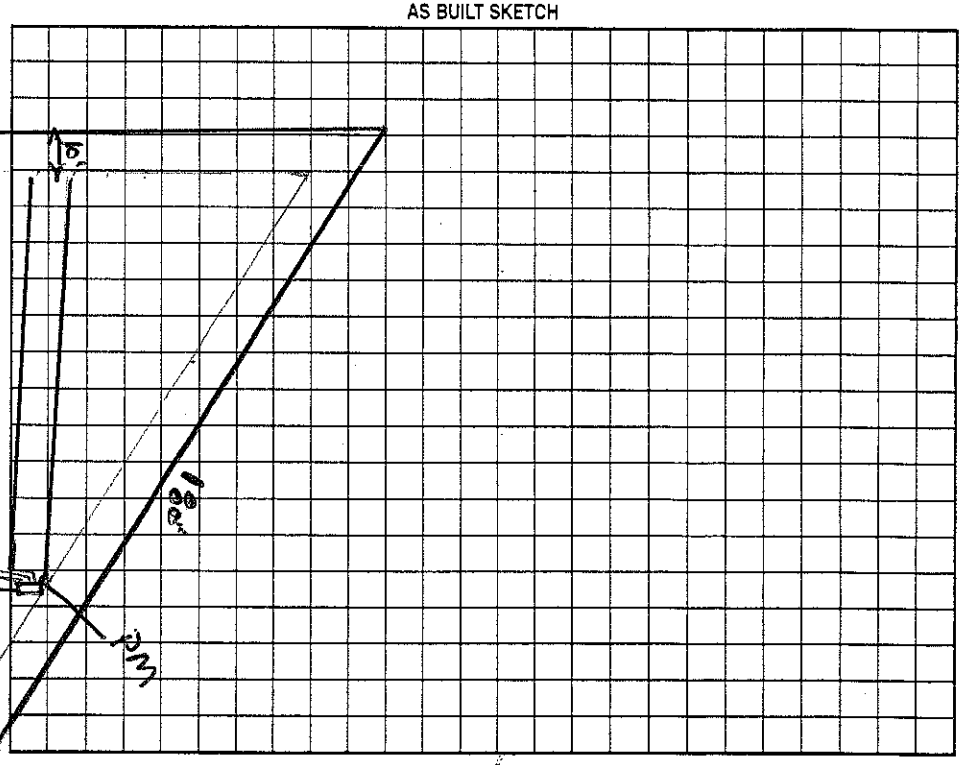

Permit can be suspended or revoked if any false information is supplied toward securing the permit/any unauthorized changes are made to the site/any unauthorized changes are made in the installation of the system. Improvement Permit with plat valid without expiration. Improvement Permit with site plan valid for sixty months. Authorization to Construct is valid for a period equal to that of Improvement Permit – not to exceed sixty months.

Signed: Thomas May date 8/2/05 Installed by: R&H RS

Improvement Permit by: Wesley Sparks RS. date 8/5/05 Operation Permit by: Marvin H Dotson RS date 1/23/07

Authorization to Construct by: [signature] RS date 5/9/06 Existing System Inspection by: date

HEALTH DEPT. COPY: WHITE OWNER COPY (FINAL): YELLOW OWNER COPY (INITIAL): PINK