IREDELL COUNTY HEALTH DEPARTMENT

AUTHORIZATION TO CONSTRUCT 4627835767

STATESVILLE 704-878-5305 MOORESVILLE 704-664-5281

IMPROVEMENT PERMIT / ~~CERTIFICATE OF COMPLETION~~ / OPERATION PERMIT / EXISTING SYSTEM INSPECTION

PROPERTY DESCRIPTION NO. 2 3810 DATE 10/25/96 TAX MAP NO. 2L-A-13 Watershed: ☑ Yes ☐ No

OWNER OR CONTRACTOR RANSEY CREEK INVESTMENTS PHONE: Business _____ Home 892-0451

ADDRESS PO BOX 1061 / CORNELIUS NC 28031

LOCATION BROWLEY SCHOOL RD - TR BLAKE - TL BEATEN PATH - LOT ON LEFT

SUBDIVISION SHAVENDERS NECK BLOCK / SECTION _____ LOT 42 LOT AREA _____ SITE CLASS. DS DESIGN FLOW 300 GPD L.T.A.R. .5 GPD/FT

Septic Tank: 1000 Gallons; STB T94 Date 2/13/97

Pump Tank: _____ Gallons; PT _____ Date _____

Pump Make: _____ Model _____ Serial No. _____

Nitrification Field: No Fields 1 Square Feet 1200 Linear Feet 400

No Lines 5 Trench Width 36" Max Trench Bottom Depth 31" Gravel Depth 10 N/A

☑ New System ☐ Repair System Type: I, II, III, IV, V, VI

System Description: GRAVITY CHAMBERED

Repair System Description: PUMP/GRAVITY PANEL

Maintenance Agreement Required: ☐ Yes ☑ No

☑ House/Mod. Home ☐ Mobile Home ☐ Business ☐ Other

No. Bedrooms 4 No. Bathrooms 4 No. Employees ____


☐ Slab ☑ Crawl Space ☐ Basement w/plumbing ☐ Basement wo/plumbing

Water Supply: ☑ Individual ☐ Community ☐ Public


Comments:

Comments:

INITIAL SITE SKETCH 1"=60'

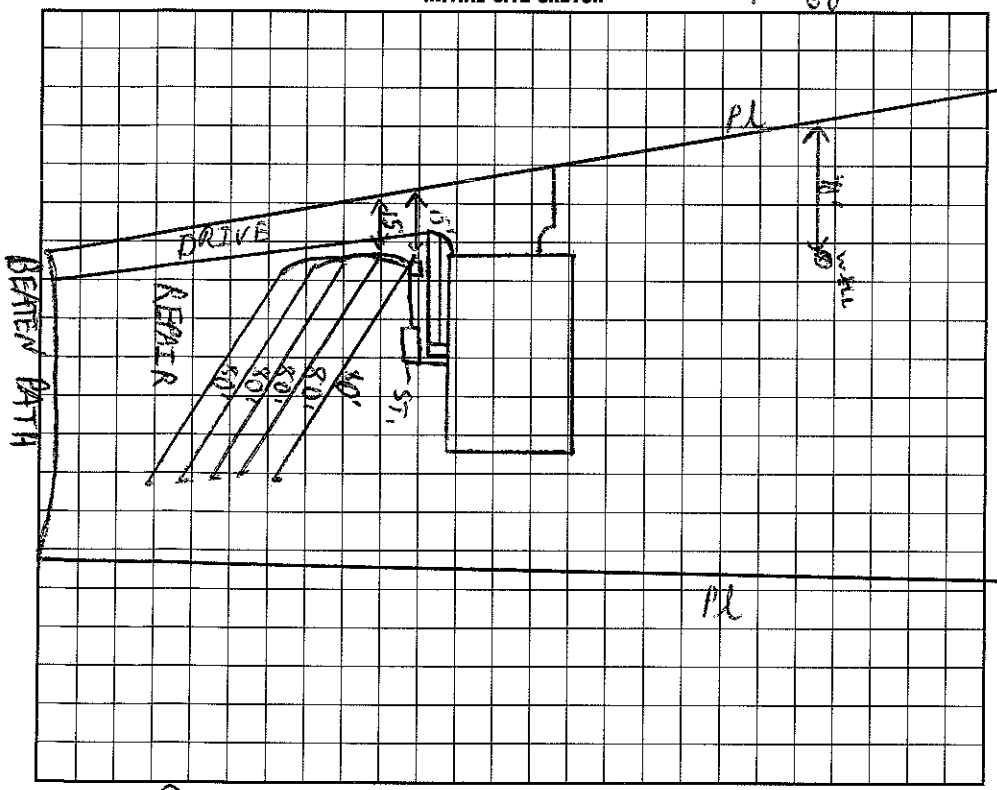

AS BUILT SKETCH

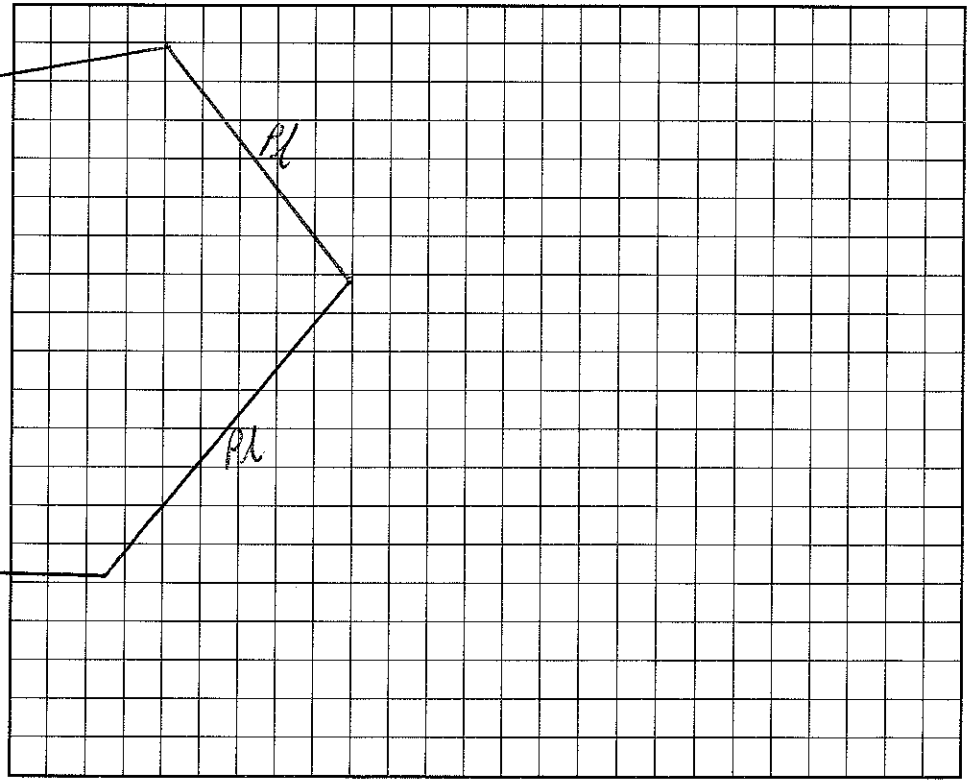

I understand that this permit can be suspended or revoked if any false information is supplied toward securing the permit/any unauthorized changes are made to the site/any unauthorized changes are made in the installation of the system.

Signed: Peyton Tucker

Improvement Permit by: C. B. Stevens EHSF date 10/25/96

AUTHORIZATION TO CONSTRUCT Existing System Inspection by: C. B. Stevens EHSF date 10/25/96

Installed by: Willie Christenbury

Certificate of Completion by: Wesley Sparks RS date 5/5/97

Operation Permit by: Wesley Sparks RS date 5/5/97

HEALTH DEPT. COPY: WHITE INSPECTION COPY (FINAL): GREEN OWNER COPY (FINAL): YELLOW INSPECTION COPY (INITIAL): PINK OWNER COPY (INITIAL): GOLD