IREDELL COUNTY HEALTH DEPARTMENT

Authorization to Construct 4627836451

STATESVILLE 704-878-5305 MOORESVILLE 704-664-5281

IMPROVEMENT PERMIT / ~~CERTIFICATE OF COMPLETION~~ / OPERATION PERMIT / EXISTING SYSTEM INSPECTION

PROPERTY DESCRIPTION NO. 23932 DATE 6/7/96 TAX MAP NO. pt of 2L-A-13 Watershed: ☑ Yes ☐ No

OWNER OR CONTRACTOR Summit Contractors PHONE: Business 948-4467 Home

ADDRESS PO Box 2368 Huntersville 28070

LOCATION Brawley School - TR Blume Rd - TL Beaten Path - 9th Lot on left

SUBDIVISION Shavender's Bluff BLOCK / SECTION LOT 44 LOT AREA 1.193ac SITE CLASS. PS DESIGN FLOW 360gpd L.T.A.R. .3gpd/ft2

Septic Tank: 1000 Gallons; STB 794 Date 10/28/96

Pump Tank: Gallons; PT Date

Pump Make: Model Serial No.

Nitrification Field: No Fields 1 Square Feet 1200 Linear Feet 400

No Lines 5 Trench Width 36" Max Trench Bottom Depth 36" Gravel Depth 12"

☑ New System ☐ Repair System Type: I, II, III, IV, V, VI

System Description: Gravity Conventional

Repair System Description: Pump/Gravity Conventional

Maintenance Agreement Required: ☐ Yes ☑ No

☑ House/Mod. Home No. Bedrooms 3

☐ Mobile Home No. Bathrooms 2

☐ Business No. Employees

☐ Other


☐ Slab ☑ Crawl Space ☐ Basement w/plumbing ☐ Basement wo/plumbing

Water Supply: ☑ Individual ☐ Community ☐ Public


Comments:

Comments:

INITIAL SITE SKETCH

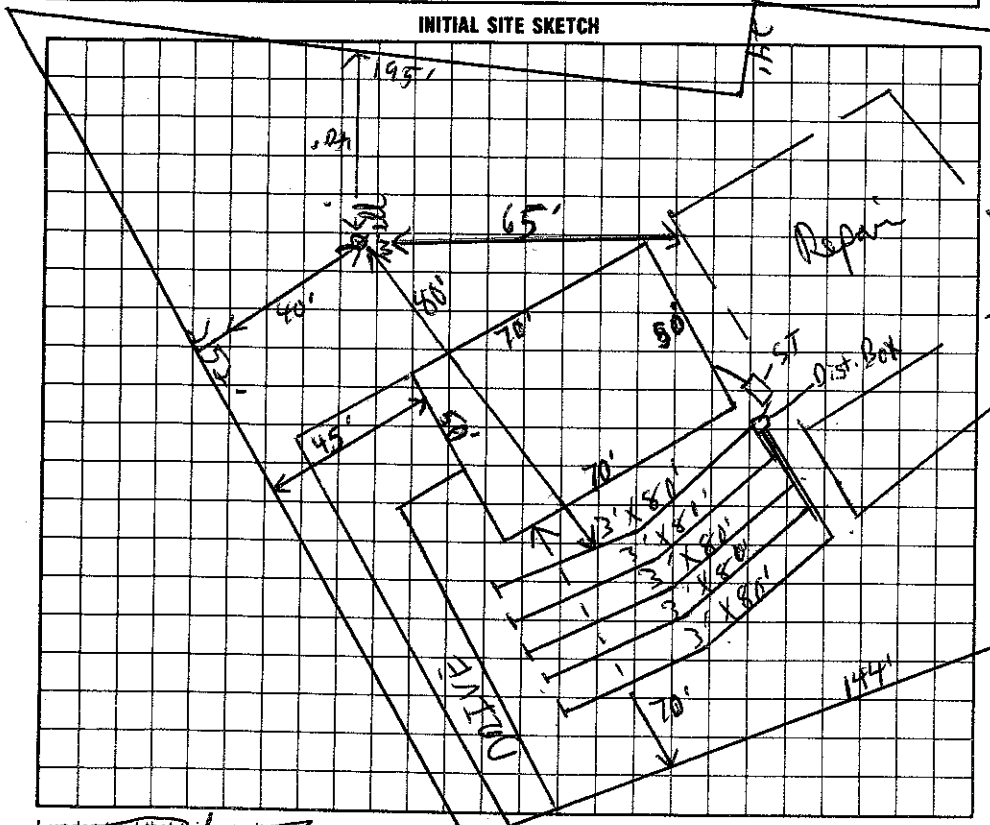

AS BUILT SKETCH

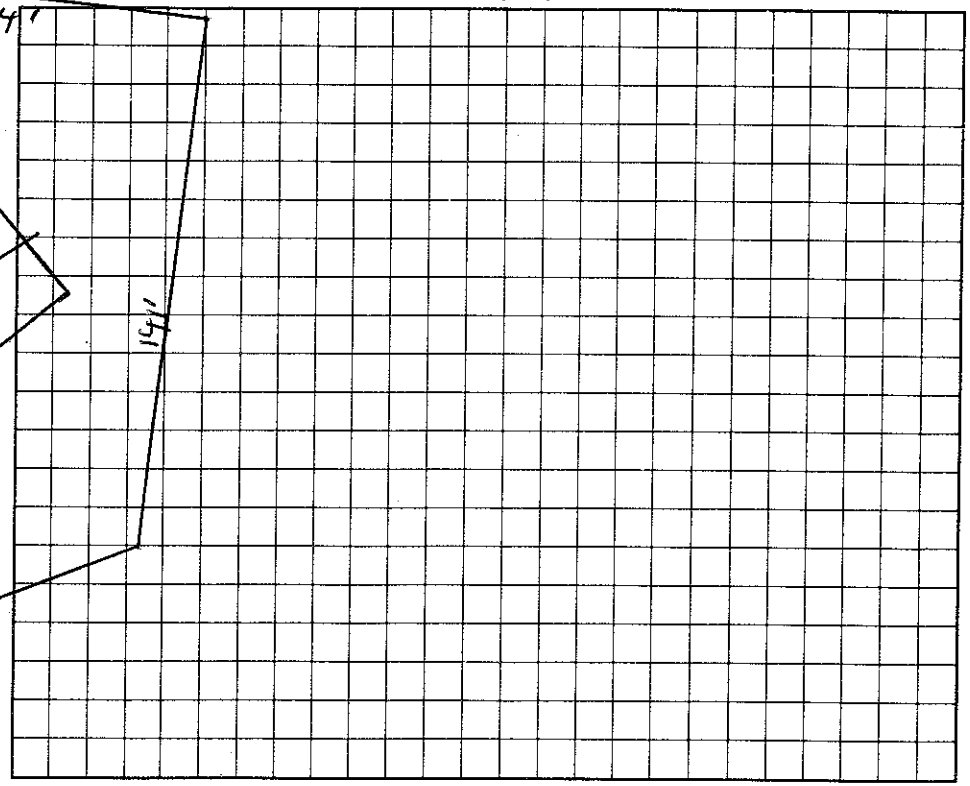

I understand that this permit can be suspended or revoked if any false information is supplied toward securing the permit/any unauthorized changes are made to the site/any unauthorized changes are made in the installation of the system.

Signed:

Installed by: Curt Dunning

Improvement Permit by: C. Rudy Freeman EHSI date 6/7/96

Authorization to Construct

~~Existing System Inspection by:~~ C. Rudy Freeman EHSI date 6/7/96

Certificate of Completion by: date

Operation Permit by: Wesley Sparks R.S. date 12/17/96

HEALTH DEPT. COPY: WHITE INSPECTION COPY (FINAL): GREEN OWNER COPY (FINAL): YELLOW INSPECTION COPY (INITIAL): PINK OWNER COPY (INITIAL): GOLD

Authorization to Construct is valid for 60 days