IREDELL COUNTY HEALTH DEPARTMENT

IMPROVEMENT PERMIT / ~~CERTIFICATE OF COMPLETION~~ / OPERATION PERMIT / EXISTING SYS.

AUTHORIZATION TO CONSTRUCT

STATESVILLE 704-878-5305 MOORESVILLE

DATE 4/7/97 TAX MAP NO. 2L-A-13 pt of 4627837134 Wat

PHONE: Business Home 892-7366

PROPERTY DESCRIPTION NO. 24047

OWNER OR CONTRACTOR PERRI MAY

ADDRESS 20117 G HENDERSON - CORNELIUS NC 28031

LOCATION BRAWLEY SCHOOL RD - TR BLUME - TL BEATEN PATH - TL BEATEN PATH - LOT ≈ .3 MILES ON L

SUBDIVISION SHAVEDERS BLUFF BLOCK / SECTION 1A LOT 45 LOT AREA .9974 AC SITE CLASS. PS DESIGN FLOW 450 GPD L.T.A.R. 3600 FT²

Septic Tank: 1000 Gallons; STB 794 Date 8/18/97

Pump Tank: 1000 Gallons; PT 27 Date 8/19/97

Pump Make: F-04DS Model WEOSIIH Serial No. F9746518

Nitrification Field: No Fields 1 Square Feet 1200 Linear Feet 400

No Lines 5@80' Trench Width 36" Max Trench Bottom Depth 36"

☑ New System ☐ Repair System Type: I, II, III, IV, V, VI

System Description: PUMP CHAMBERED

Repair System Description: PUMP PANEL

Maintenance Agreement Required: ☐ Yes ☑ No

☐ Slab ☑ Crawl Space ☐ Basement w/plumbing ☐ Basement wo/plumbing

☑ House/Mod. Home No. Bedrooms 4

☐ Mobile Home No. Bathrooms 4

☐ Business No. Employees


☐ Other

Water Supply: ☑ Individual ☐ Community ☐ Public


Comments:

Comments:

INITIAL SITE SKETCH 1"=60'

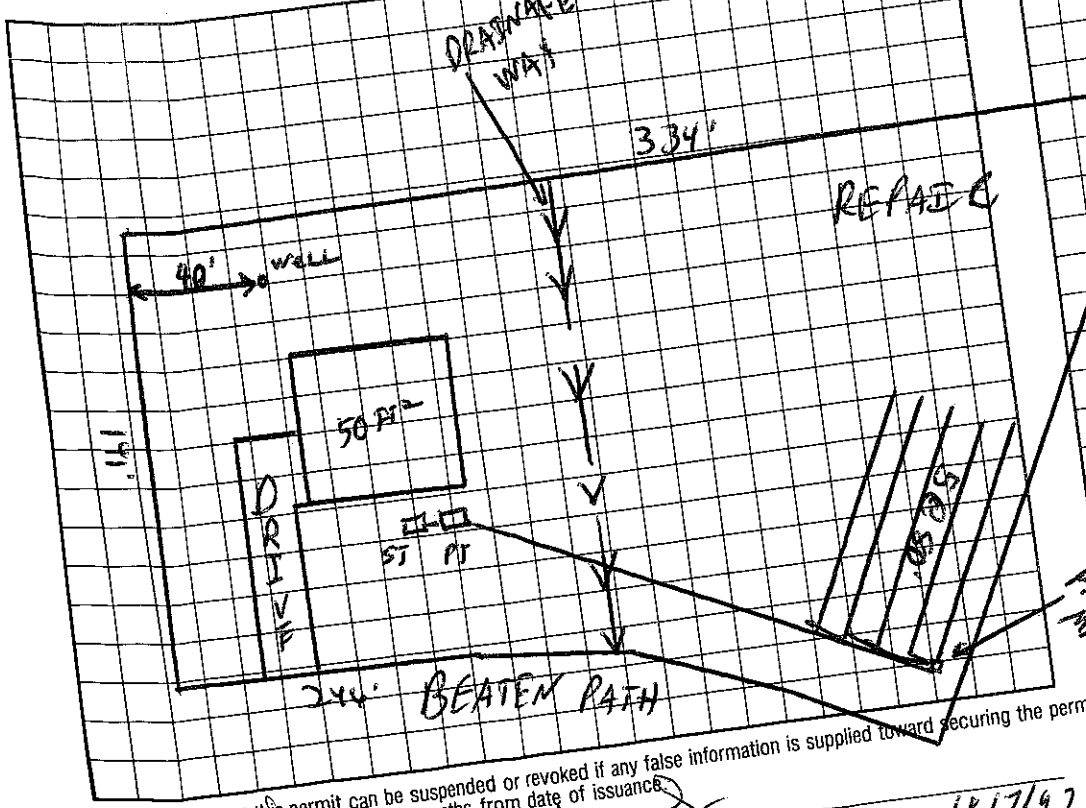

AS BUILT SKETCH

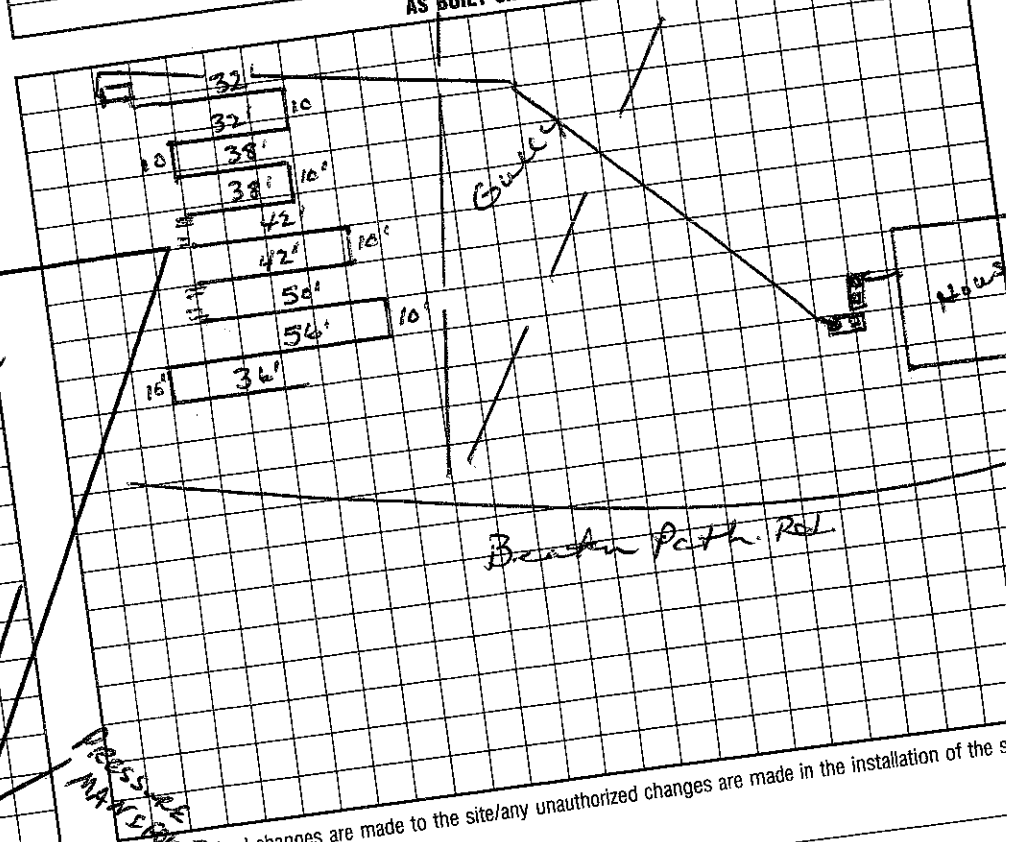

I understand that this permit can be suspended or revoked if any false information is supplied toward securing the permit/any unauthorized changes are made to the site/any unauthorized changes are made in the installation of the s

Improvement Permit is valid for 60 months from date of issuance.

Installed by: F J Enviro date

Certificate of Completion by: date 4/7/97