IREDELL COUNTY HEALTH DEPARTMENT 462784 1909

Statesville Phone TR 3-7271 Mooresville Phone NO 3-1271

PERMIT TO INSTALL SEPTIC TANK

Permit NO._____ Permit Date 9 Sept 1964

Owner Mr. Johnson Address Charlotte N.C.

Installed By Denver Plumbing Co. Address Denver N.C.


Location of Property Sec 9 Lot 98

Tank		Capacity		Length of Lines		Fixtures	
Block	( )	800	( )	150'	( )	No. of Baths	( )
Precast	(2)	900	( )	175'	( )	Dishwasher	( )
		1000	(✓)	200'	( )	Garbage Grdr.	( )
		1100	( )	225'	(✓)	Auto-Washer	( )
		1200	( )	250'	( )	Other_____	
		Other_____		Other_____			

NOTIFY HEALTH DEPARTMENT AT LEAST EIGHT HOURS BEFORE TANK IS TO BE INSPECTED.

Final Inspection 9 Sept 1964 Approved (X) Disapproved ( )

Remarks_____

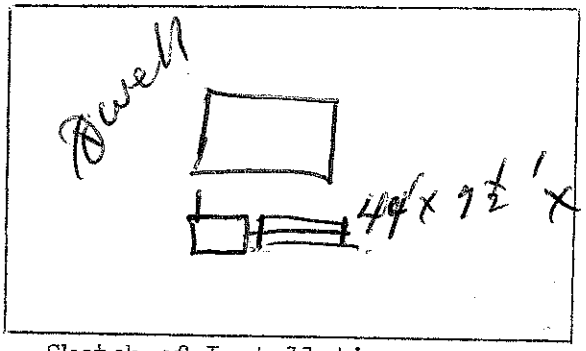

Sketch of Installation

Dilly Swaggin
Sanitarian