IREDELL COUNTY HEALTH DEPARTMENT

STATESVILLE 704-878-5305 MOORESVILLE 704-664

IMPROVEMENT PERMIT / ~~CERTIFICATE OF COMPLETION~~ / OPERATION PERMIT / EXISTING SYSTEM

4627844070

PROPERTY DESCRIPTION NO. 23824 DATE 6/17/96 TAX MAP NO. 2L-A-13 pt of Water

OWNER OR CONTRACTOR ~~Brad & Cathy Bowen~~ BOWEN PHONE: Business Home 664-2163

ADDRESS PO Box 117 Mt Mourne 28123 INCORP

LOCATION Brawley School - TR Blume Rd - TL Beaver Pond - 2nd lot on right

SUBDIVISION Shareholders Bluff BLOCK / SECTION LOT 37 LOT AREA SITE CLASS. RS DESIGN FLOW 480gpd L.T.A.R. .5gpd/ft²

Septic Tank: 1000 Gallons; STB 794 Date 5/14/96

Pump Tank: Gallons; PT Date

Pump Make: Model Serial No.

Nitrification Field: No Fields 1 Square Feet 1200 Linear Feet 400

No Lines 5 @ 80' Trench Width 36" Max Trench Bottom Depth 36" Gravel Depth N/A

☑ New System ☐ Repair System Type: I, II, III, IV, V, VI

System Description: Gravity Conventional

Repair System Description:

Maintenance Agreement Required: ☐ Yes ☑ No

☑ House/Mod. Home No. Bedrooms 3

☐ Mobile Home No. Bathrooms 2.5

☐ Business No. Employees

☐ Other


☐ Slab ☑ Crawl Space ☐ Basement w/plumbing ☐ Basement wo/plumbing

Water Supply: ☑ Individual ☐ Community ☐ Public


Comments:

Comments: Changing from 4Bdrm to 3bdrm
Okay to install 400' Gravity Conventional
8/19/98 MD

INITIAL SITE SKETCH

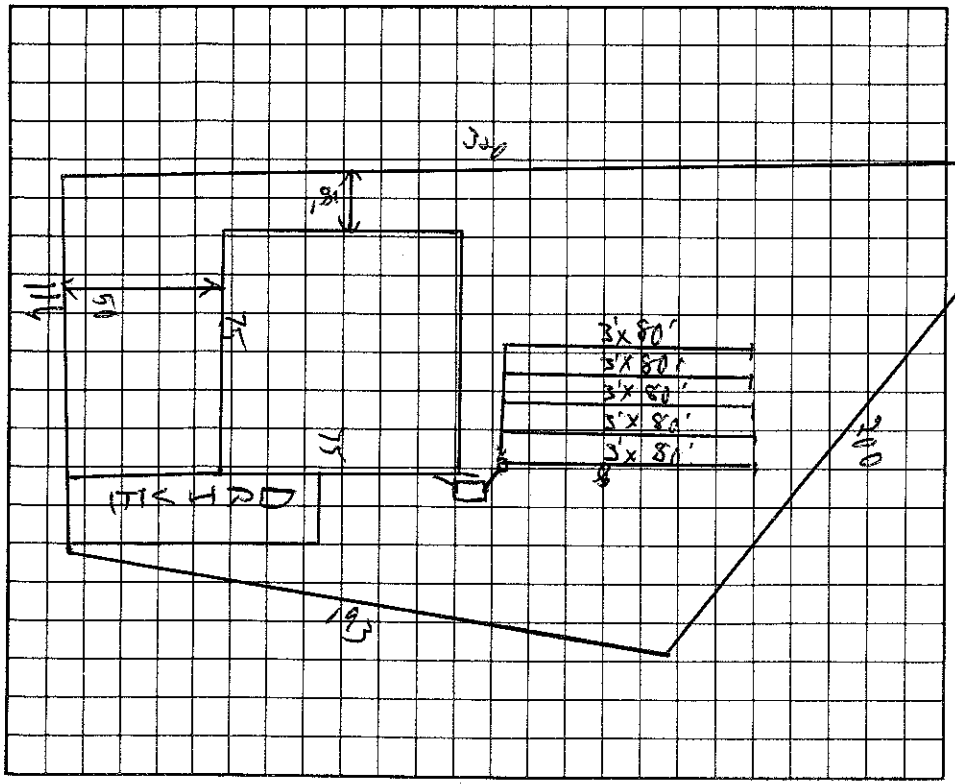

AS BUILT SKETCH

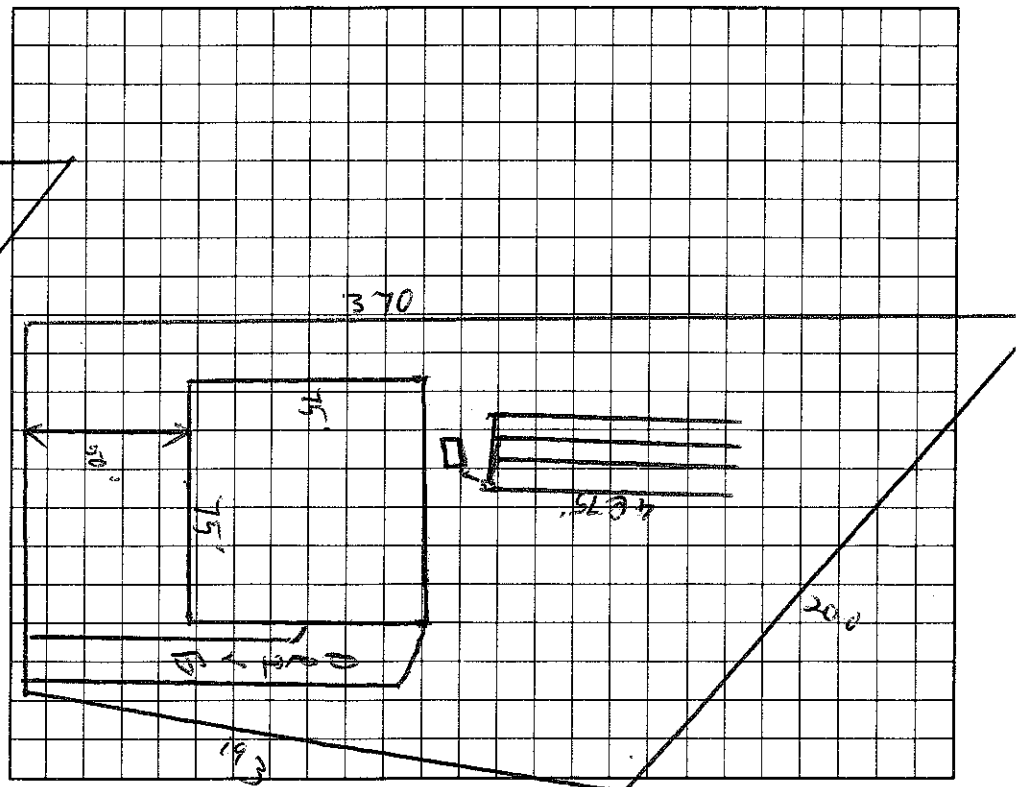

I understand that this permit can be suspended or revoked if any false information is supplied toward securing the permit/any unauthorized changes are made to the site/any unauthorized changes are made in the installation of the system.

Signed: Cathleen Bowen

Improvement Permit by: C. Riley Thomas EHSI date 6/17/96

Authorization to Construct / ~~Existing System Inspection~~ by: C. Riley Thomas EHSI date 6/17/96

Installed by: LARRY BEAM

Certificate of Completion by: date

Operation Permit by: C. Riley Thomas date 8/27/98

HEALTH DEPT. COPY: WHITE INSPECTION COPY (FINAL): GREEN OWNER COPY (FINAL): YELLOW INSPECTION COPY (INITIAL): PINK OWNER COPY (INITIAL): GOLD

Authorization to Construct is valid for 60 months from issue date