# IREDELL COUNTY HEALTH DEPARTMENT

STATESVILLE 704-878-5305 MOORESVILLE 704-664-5281

## IMPROVEMENT PERMIT / AUTHORIZATION TO CONSTRUCT / OPERATION PERMIT / EXISTING SYSTEM INSPECTION

PERMIT# 107667 PIN# 4627844388 DATE 7/22/2002

OWNER OR CONTRACTOR Bobby Stevens PHONE: Business Home 660-6537

ADDRESS 418 Beaten Path Mooresville NC

LOCATION Brawley School Rd TR Blume TL Beaten Path ~ 1.5 miles on Rt

SUBDIVISION BLOCK / SECTION LOT LOT AREA SITE CLASS. DESIGN FLOW L.T.A.R.

Septic Tank: Existing Gallons; STB Date

Pump Tank: Gallons; PT Date

Pump Make: Model Serial No.

Nitrification Field: No Fields Square Feet Linear Feet

No Lines Trench Width Max Trench Bottom Depth Gravel Depth

☐ New System ☐ Repair System Type: I II III IV V VI

System Description: Existing Gravity-Convent.

Repair System Description:

Maintenance Agreement Required: ☐ Yes ☒ No

☒ House/Mod. Home No. Bedrooms 3

☐ Mobile Home No. Bathrooms 3.5

☐ Business No. Employees

☐ Other


☐ Slab ☒ Crawl Space ☒ Basement w/plumbing ☐ Basement wo/plumbing

Water Supply: ☒ Individual ☐ Public ☐ Community

Comments:/Conditions: Existing Septic System appears to be functioning okay at time of inspection

Comments:/Conditions: Proposed addition to include existing patio & deck Keep foundations footers/piers at least 5' from existing Septic System

INITIAL SITE SKETCH Not to Scale

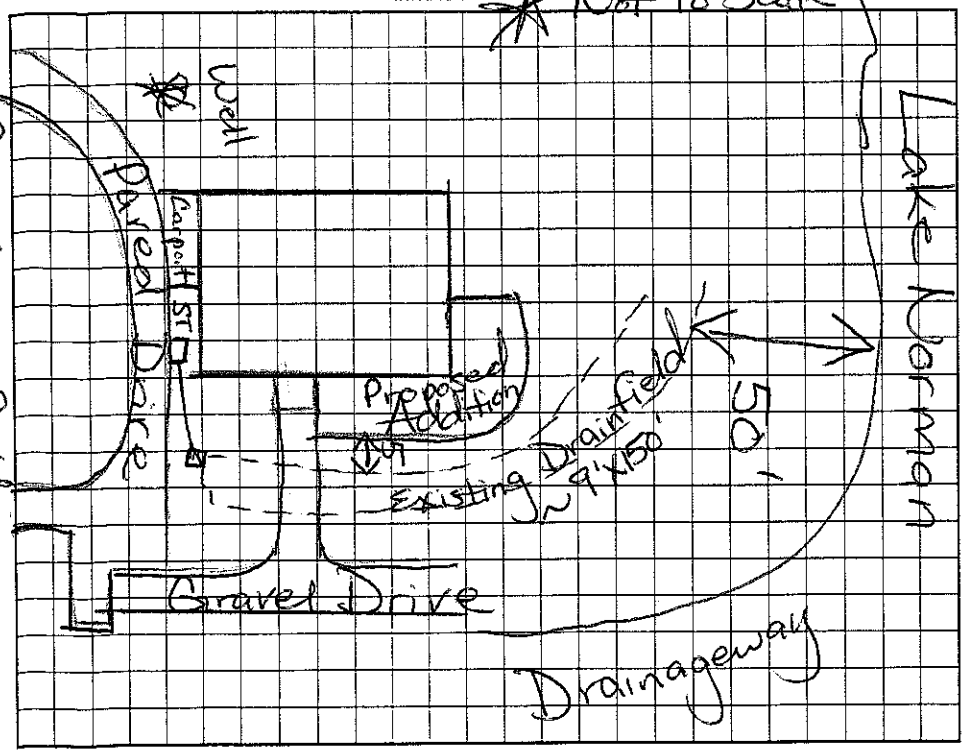


AS BUILT SKETCH

Septic System originally installed 1986 under Walter Mauney installed by Dobson

Permit can be suspended or revoked if any false information is supplied toward securing the permit/any unauthorized changes are made to the site/any unauthorized changes are made in the installation of the system. Improvement Permit with plat valid without expiration. Improvement Permit with site plan valid for sixty months. Authorization to Construct is valid for a period equal to that of Improvement Permit – not to exceed sixty months.

Signed: X Bobby Stevens date Installed by:

Improvement Permit by: Marian H. Dobson RS date 7/22/02 Operation Permit by: RS date

Authorization to Construct by: date Existing System Inspection by: Marian H. Dobson date 7/22/02

HEALTH DEPT. COPY: WHITE OWNER COPY (FINAL): YELLOW OWNER COPY (INITIAL): PINK