IREDELL COUNTY HEALTH DEPARTMENT

Authorization to Construct 4627845142

STATESVILLE 704-878-5305 MOORESVILLE 704-664-5281

IMPROVEMENT PERMIT / ~~CERTIFICATE OF COMPLETION~~ / OPERATION PERMIT / EXISTING SYSTEM INSPECTION

PROPERTY DESCRIPTION NO. 23933 DATE 6/7/96 TAX MAP NO. Pt of 2L-4-13 Watershed: ☑ Yes ☐ No

OWNER OR CONTRACTOR Summit Contractors PHONE: Business 946-4467 Home

ADDRESS PO Box 2368 Huntersville 28070

LOCATION Brantley School TR Blume Rd - TL Beaton Path - Corner of Beaton Path forks

SUBDIVISION Shoemaker's Old BLOCK / SECTION LOT 36 LOT AREA .8342 SITE CLASS PS DESIGN FLOW 480gpd L.T.A.R. .3 gpd/fpa

Septic Tank: 1000 Gallons; STB 794 Date 1/14/97

Pump Tank: Gallons; PT Date

Pump Make: Model Serial No.

Nitrification Field: No Fields 1 Square Feet 1600 Linear Feet 533

No Lines 4 Trench Width 36" Max Trench Bottom Depth 36" Gravel Depth 12"

☑ New System ☐ Repair System Type: I II III IV V VI

System Description: Gravity Conventional

Repair System Description: Chambered

Maintenance Agreement Required: ☐ Yes ☑ No

☑ House/Mod. Home No. Bedrooms 4

☐ Mobile Home No. Bathrooms 2.5

☐ Business No. Employees

☐ Other


☐ Slab ☑ Crawl Space ☐ Basement w/plumbing ☐ Basement wo/plumbing

Water Supply: ☑ Individual ☐ Community ☐ Public

Comments:

Comments:

INITIAL SITE SKETCH 1" = 60'

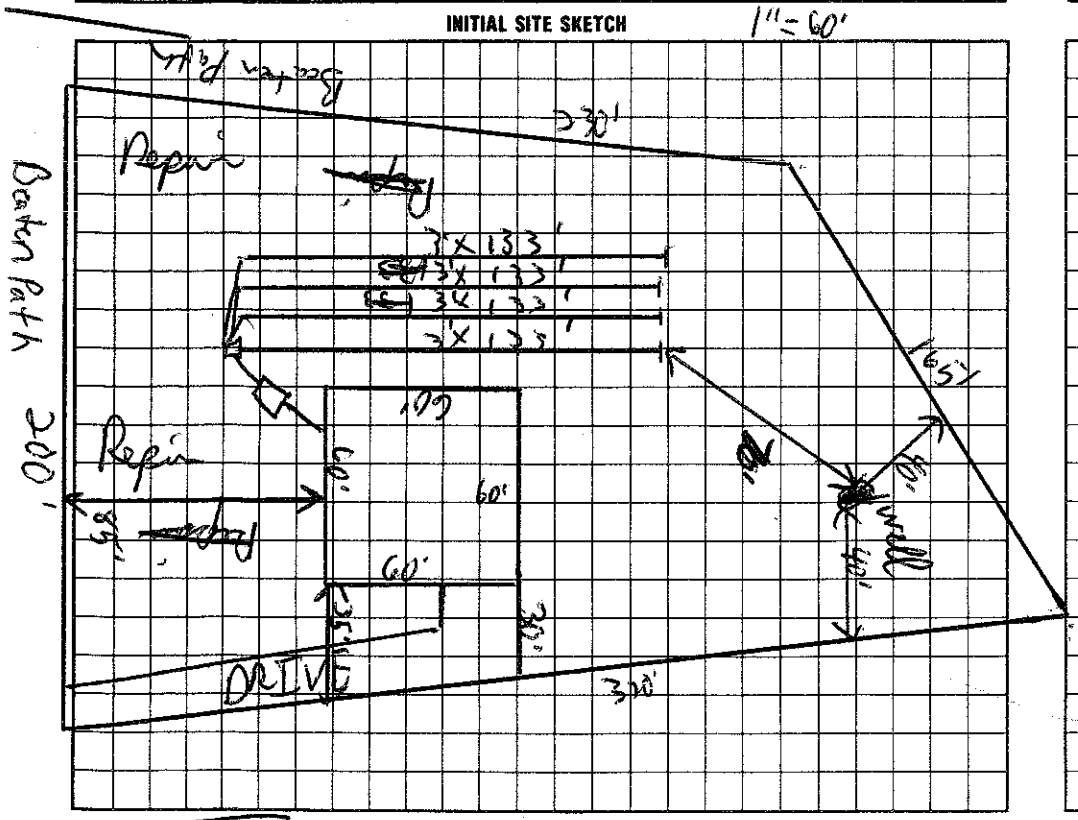

AS BUILT SKETCH

I understand that this permit can be suspended or revoked if any false information is supplied toward securing the permit/any unauthorized changes are made to the site/any unauthorized changes are made in the installation of the system.

Signed:

Installed by: Grant Dunning Construction

Improvement Permit by: C. Bobby Freeman EHSF date 6/7/96

Authorization to Construct

Existing System Inspection by: C. Bobby Freeman EHSF date 6/7/96

Certificate of Completion by: Wesley Sparks R.S. date 4/1/97

Operation Permit by: Wesley Sparks R.S. date 4/1/97

HEALTH DEPT. COPY: WHITE INSPECTION COPY (FINAL): GREEN OWNER COPY (FINAL): YELLOW INSPECTION COPY (INITIAL): PINK OWNER COPY (INITIAL): GOLD