IREDELL COUNTY HEALTH DEPARTMENT

STATESVILLE 704-878-5305 50.00 Paid MOORESVILLE 704-664-5281

IMPROVEMENT PERMIT / AUTHORIZATION TO CONSTRUCT / OPERATION PERMIT / EXISTING SYSTEM INSPECTION

PERMIT# ~~07 507~~ 07346 PIN# 4627-85-4041

OWNER OR CONTRACTOR Michael Harper DATE 7/15/02

ADDRESS PO Box 1463 Matthews NC 28105 PHONE: Business 704-400-2344 Home

LOCATION Brawley sch, TR Blume, TL Beaten Path, Asbury Cir, on Rt Inside Circle

SUBDIVISION Shavender's Bluff BLOCK / SECTION LOT 11 LOT AREA 1.199 AC SITE CLASS PS DESIGN FLOW 480 L.T.A.R. 0-3

Septic Tank: 1000 Gallons; STB 744 Date 6/25/02

Pump Tank: ~~1000~~ Gallons; PT Date

Pump Make: Model Serial No.

Nitrification Field: No Fields 1 Square Feet 560 Linear Feet 280

No Lines 8 @ 35' Trench Width 24" Max Trench Bottom Depth 36" Gravel Depth —

☒ New System ☐ Repair System Type: I, II, (III) IV, V, VI

System Description: Gravity Panel Block

Repair System Description: Panel Block

Maintenance Agreement Required: ☐ Yes ☒ No

☒ House/Mod. Home ☐ Mobile Home ☐ Business ☐ Other

No. Bedrooms 4 No. Bathrooms 4 No. Employees


☐ Slab ☒ Crawl Space ☒ Basement w/plumbing ☐ Basement wo/plumbing

Water Supply: ☒ Individual ☐ Public ☐ Community

Comments:/Conditions:

Comments:/Conditions:

INITIAL SITE SKETCH

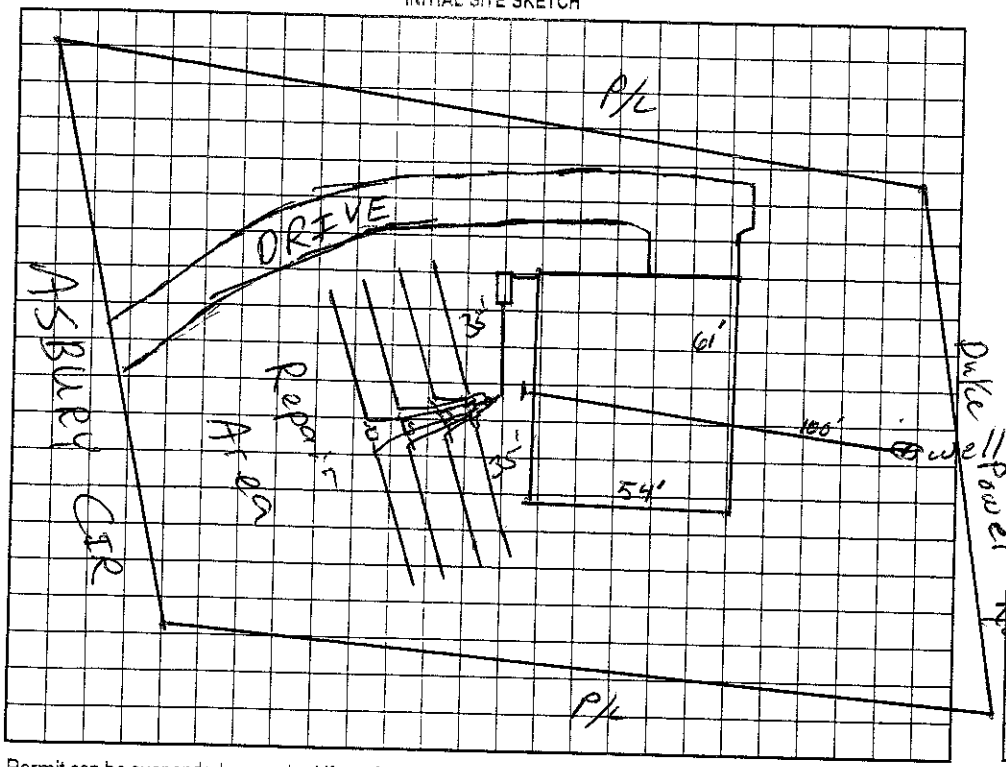

AS BUILT SKETCH

Installed w/ Deep Boxes

Permit can be suspended or revoked if any false information is supplied toward securing the permit/any unauthorized changes are made to the site/any unauthorized changes are made in the installation of the system. Improvement Permit with plat valid without expiration. Improvement Permit with site plan valid for sixty months. Authorization to Construct is valid for a period equal to that of Improvement Permit – not to exceed sixty months.

Signed: date 7-15-02 Installed by: Abernathy

Improvement Permit by: RS date 7/15/02 Operation Permit by: RS date 11/14/02

Authorization to Construct by: RS date 7/15/02 Existing System Inspection by: date

HEALTH DEPT. COPY: WHITE OWNER COPY (FINAL): YELLOW OWNER COPY (INITIAL): PINK