DELL COUNTY HEALTH DEPARTMENT

...ESVILLE 704-878-5305 MOORESVILLE 704-664-5281

ROVEMENT PERMIT / AUTHORIZATION TO CONSTRUCT / OPERATION PERMIT / EXISTING SYSTEM INSPECTION

195 976 263 1:30

ERMIT# 08630 PIN# 4627 85 4133 DATE 12/10/99

OWNER OR CONTRACTOR John T Pappas PHONE: Business Home 799-0571

ADDRESS 121 Birdie Ct. Mooresville, NC. 28117

LOCATION 1100 TR Blume TL Beaton Path bear R on Asbury Cir, (L) to ~3RD lot on (R)

SUBDIVISION Shevenders Bluff BLOCK / SECTION 1 LOT 12 LOT AREA ~1.24 AC SITE CLASS. PS DESIGN FLOW 480 L.T.A.R. .3

Septic Tank: 1000 Gallons; STB 012 Date 5-12-00
Pump Tank: 1000 Gallons; PT 17 Date 5-12-00
Pump Make: Myers Model ME40 Serial No.
Nitrification Field: No Fields 1 Square Feet 810 Linear Feet 270
No Lines 3 Trench Width 36" Max Trench Bottom Depth 36" Gravel Depth SAND.

[X] New System [ ] Repair System Type: I, II, III (IV) V, VI
System Description: Pressdosed 16" PPBS *
Repair System Description: SAME
Maintenance Agreement Required: [X] Yes [ ] No


[X] House/Mod. Home No. Bedrooms 4
[ ] Mobile Home No. Bathrooms 4
[ ] Business No. Employees
[ ] Other
[ ] Slab [X] Crawl Space [ ] Basement w/plumbing [ ] Basement wo/plumbing

Water Supply: [X] Individual [ ] Public [ ] Community


Comments:/Conditions: * This is 50% reduction system

Comments:/Conditions: Tanks, lines, & pressure tested. 8/10/2000
Check for rope of pump (needs rope)

INITIAL SITE SKETCH (1" = 50')

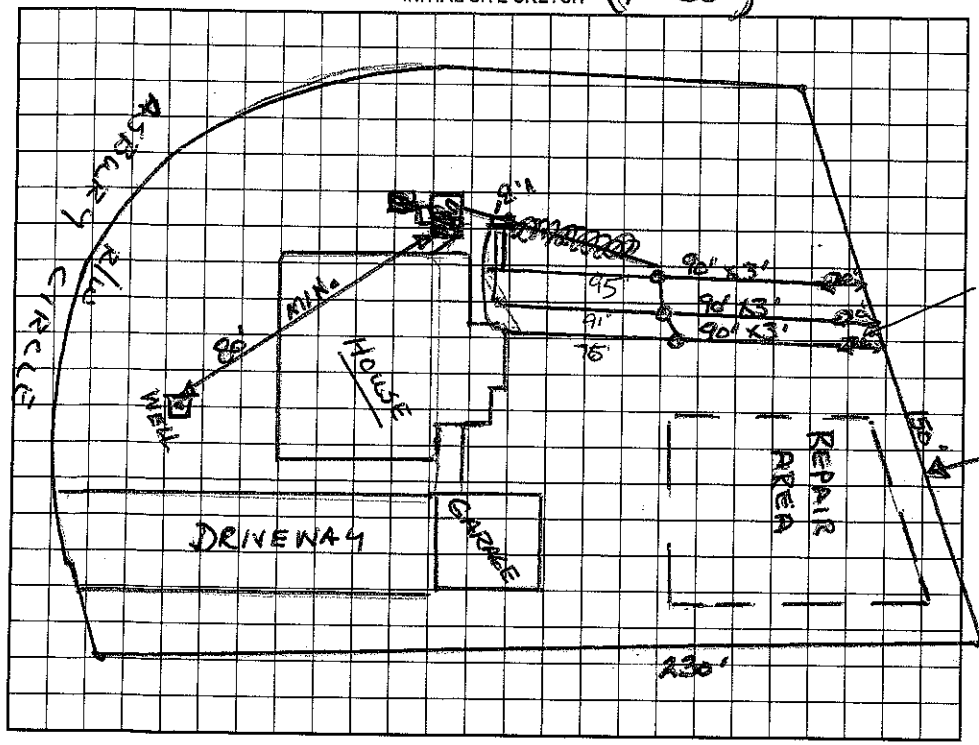

AS BUILT SKETCH

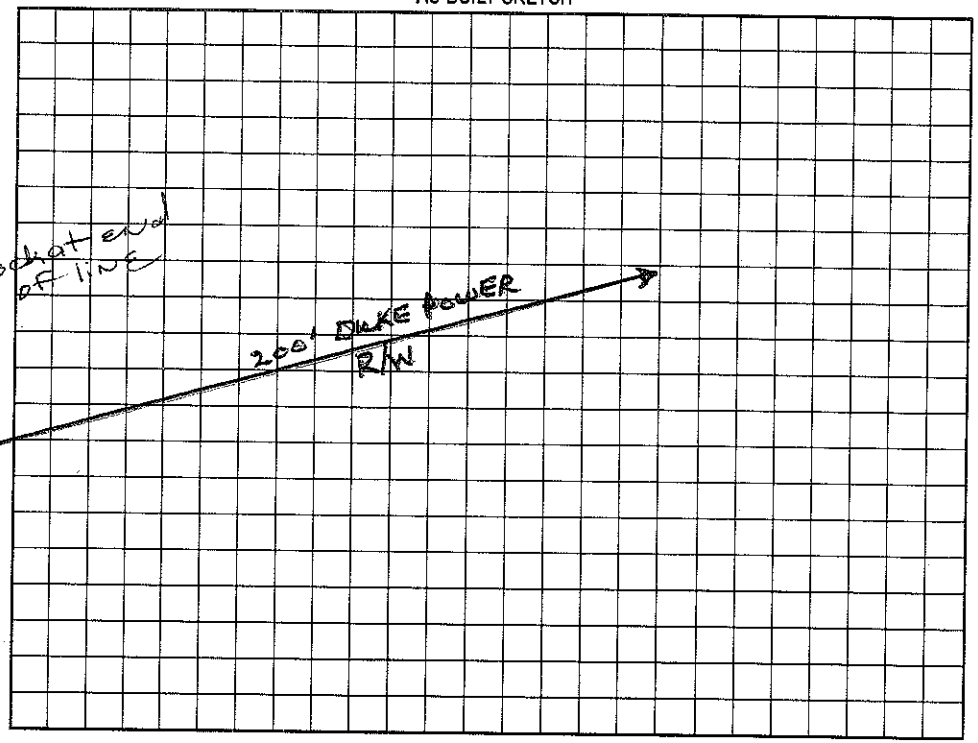

Permit can be suspended or revoked if any false information is supplied toward securing the permit/any unauthorized changes are made to the site/any unauthorized changes are made in the installation of the system. Improvement Permit with plat valid without expiration. Improvement Permit with site plan valid for sixty months. Authorization to Construct is valid for a period equal to that of Improvement Permit – not to exceed sixty months.

Signed: * [signature] date 12/16/99

Improvement Permit by: Wesley Sparks RS. date 12/10/99

Authorization to Construct by: Wesley Sparks RS. date 12/10/99

Installed by: Richard Abernathy

Operation Permit by: Wesley Sparks RS. date 10/27/00

Existing System Inspection by: date

HEALTH DEPT. COPY: WHITE OWNER COPY (FINAL): YELLOW OWNER COPY (INITIAL): PINK