IREDELL COUNTY HEALTH DEPARTMENT

Statesville Office (704) 878-5305 Mooresville Office (704) 660-3625 PERMIT # 210720

IMPROVEMENT PERMIT / AUTHORIZATION TO CONSTRUCT / OPERATION PERMIT / EXISTING SYSTEM

PIN # 4627-85-4346.000

APPLICANT: West Hunter APPLICANT ADDRESS: 165 Asbury Cir. Mooresville NC

SITE ADDRESS: 165 Asbury Cir. Mooresville NC PHONE: 704-363-5889 ALT. PHONE:

SITE DIRECTIONS: BSR, TR Rumbe, TL Beaten Path, TR Asbury, Site on R

SUBDIVISION: CL & T SECTION: 9 LOT # 1530 LOT AREA: 1.390 Acre DESIGN FLOW: 480 GPD (Existing) L.T.A.R.: Existing

Septic Tank 1500 (gal) STB 379 Date 7-11-16
Pump Tank 1500 (gal) PT 379 Date 7-15-16
Pump Make ____ Model ____ Serial # ____
Nitrification Fields Exist. # Lines Existing Linear Ft: Exist
Trench Width Existing Max. Trench Bottom Depth Existing Gravel Depth N/A

☐ New System ☐ Repair ☐ Expansion System Type: I II (III) IV V VI
System Description: Existing PM 25% Reduct.
Repair System Description: LPP2P5
Maintenance Agreement Required: ☐ YES ☒ NO
☐ GRAVITY ☒ PRESSURE

☒ Residence No. Bedrooms Ex 4
☐ Business No. Persons Ex 8
☐ Other No. Employees
☐ Slab ☐ Crawl Space
☒ Basement w/plumbing ☐ Basement w/o plumbing

Water Supply: ☒ Private ☐ Public ☐ Community

Comments / Conditions: Relocate Tanks To Accomodate For Pool. Maintain 5' Separation From Buildings Structures And 15' From Pool Wall With Septic.

Same Tanks Installed / Hole Cut In Baffle Wall Of Pump Tank

INITIAL SITE SKETCH

See Attached / Approved Design

By / Tony C. Jacobs, Jac135

On-Site Development, Inc.

Dated APPROVED AUG 04 2015

AS BUILT SKETCH

Permit can be suspended or revoked if any false information is supplied toward securing the permit / any unauthorized changes are made to the site / any unauthorized changes are made in the installation of the system. **CONTACT A LOCATOR SERVICE PRIOR TO ANY EXCAVATION**

☐ **IMPROVEMENT PERMIT** *with plat valid without expiration.* ☒ **IMPROVEMENT PERMIT** *with site plan valid for 60 mos.* ☒ **AUTHORIZATION TO CONSTRUCT** *valid for period equal to IMPROVEMENT PERMIT--not to exceed 60 mo.*

Owner / Applicant Signature: West Hunter Date: 10/5/15 Installed by: R&H

IMPROVEMENT PERMIT by: APPROVED AUG 04 2015 OPERATION PERMIT by: APPROVED MAR 17 2016

AUTHORIZATION TO CONSTRUCT by: APPROVED AUG 04 2015 Existing System Inspected by: Date:

Health Dept. Copy - WHITE Applicant (Final Approval) - YELLOW Applicant (Conditional Approval) - PINK


REVISED TO SHOW 18" RCP 2ND AUGUST 1999
REVISED TO CORRECT NAME SEPTEMBER 8TH, 1999

SIGNED _____

R. B. PHARR & ASSOCIATES, PROFESSIONAL SURVEYORS
19801 S. MAIN STREET
CORNELIUS, NC 28031
TEL: 704-895-1730
FAX: 704-895-1964
EMAIL: PHARRNORTH@RBPHARR.COM

CREW	DRAWN	REVISED
C1	TK	JL


REVISED 7-1-02 TO ADD HOUSE.
REVISED 7-2-02 TO MOVE HOUSE TO FIELD LOCATION.

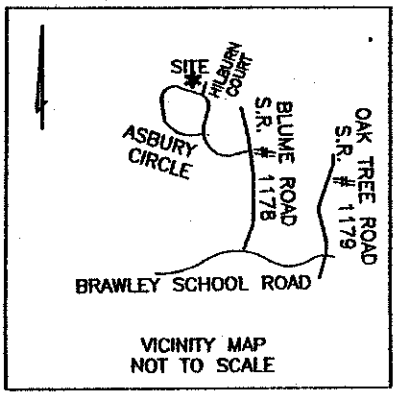

VICINITY MAP
NOT TO SCALE

REFERENCE MAP BOOK 25-9

LINE TABLE		
LINE #	BEARING	DISTANCE
L1	S 70° 58' 00" E	27.19'
L2	N 54° 52' 00" E	22.20'
L3	N 60° 40' 00" E	11.18'
L4	N 69° 09' 00" E	13.00'
L5	S 39° 09' 00" E	28.84'
L6	N 42° 22' 00" E	18.79'
L7	S 56° 53' 00" E	21.84'
L8	S 25° 07' 00" E	14.87'
L9	S 65° 14' 00" E	15.13'
L10	S 57° 15' 00" E	32.74'
L11	N 42° 01' 00" E	37.64'
L12	S 88° 43' 00" E	22.47'
L13	S 82° 32' 00" E	52.89'
L14	S 62° 37' 00" E	35.51'
L15	S 50° 33' 00" E	16.61'
L16	S 72° 44' 53" E	27.78'

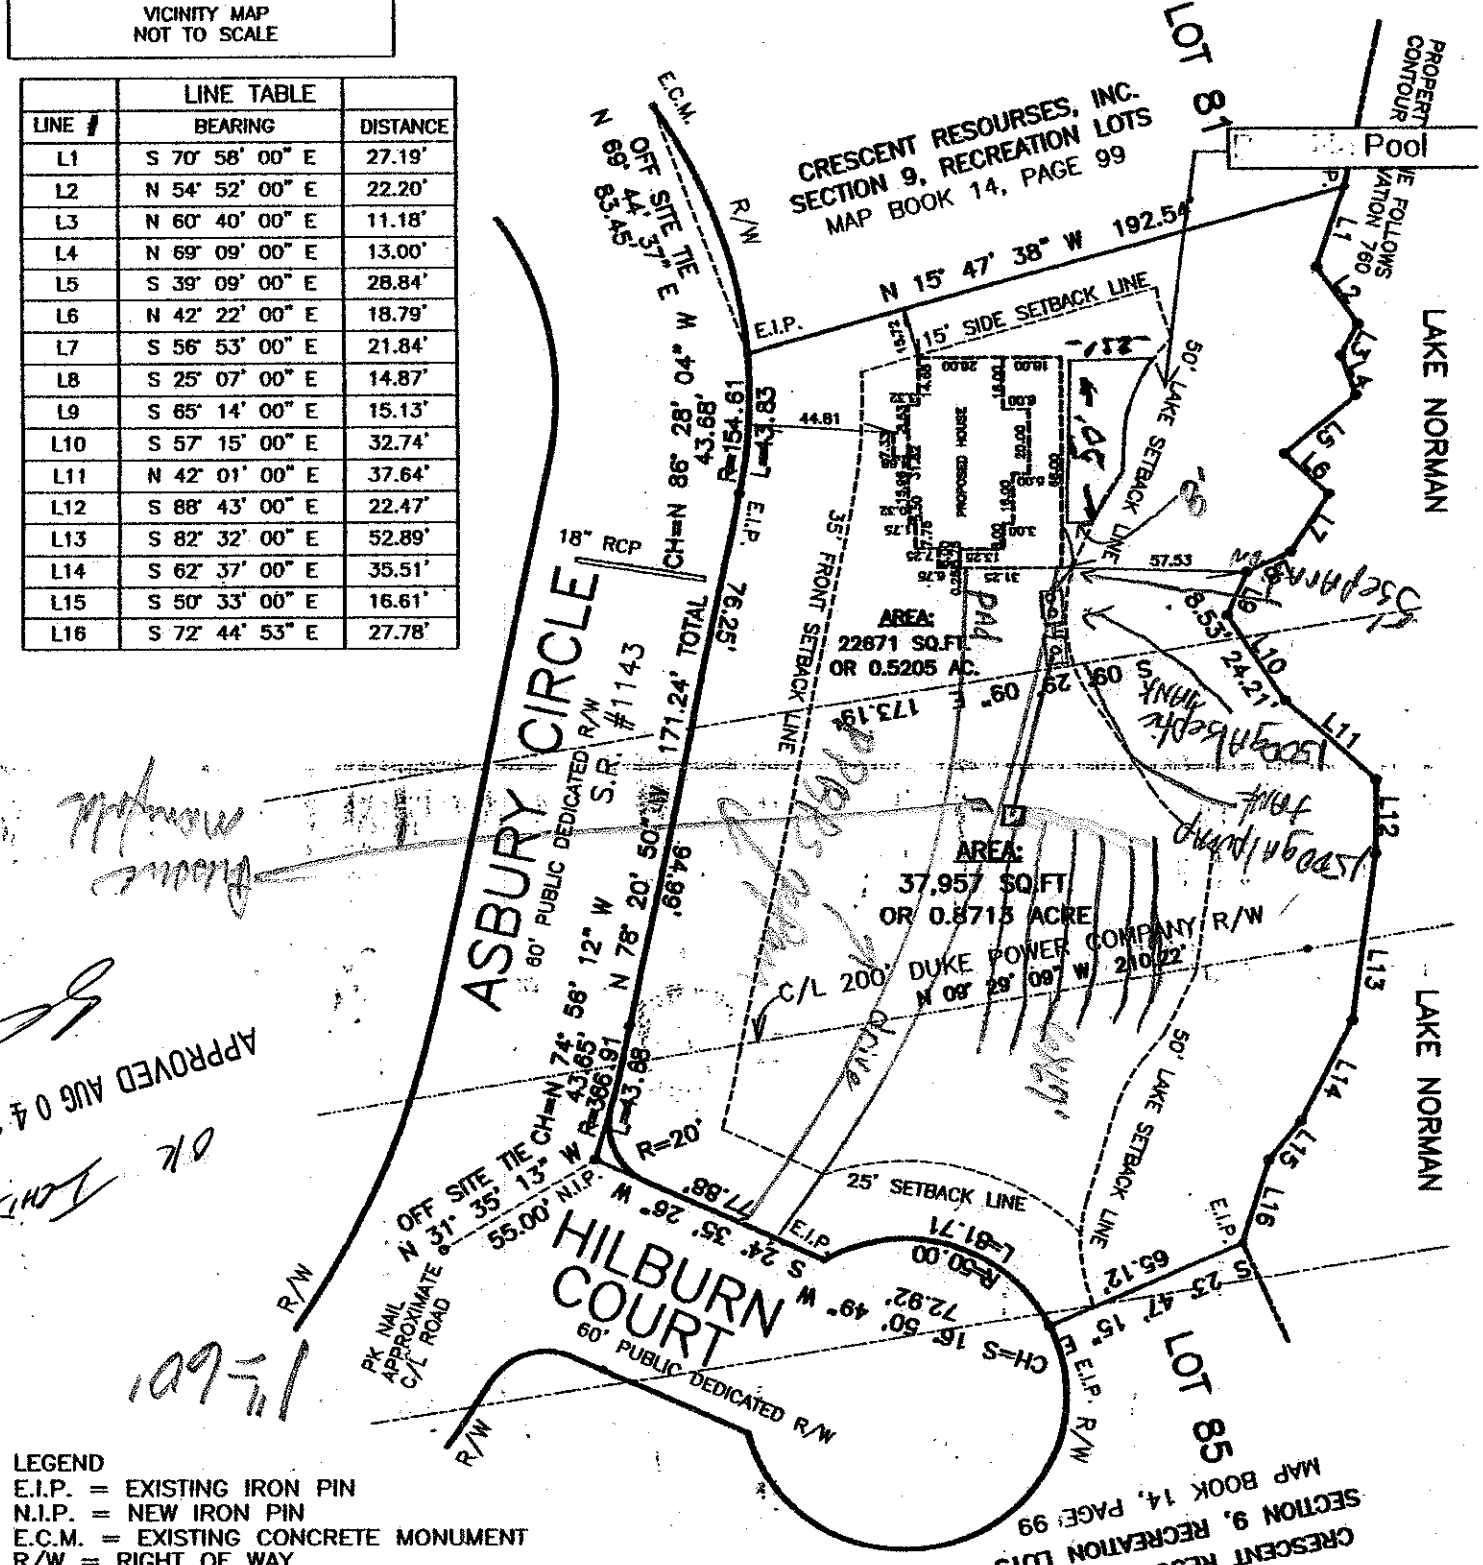

LEGEND
E.I.P. = EXISTING IRON PIN
N.I.P. = NEW IRON PIN
E.C.M. = EXISTING CONCRETE MONUMENT
R/W = RIGHT OF WAY
C/L = CENTER LINE
RCP = REINFORCED CONCRETE PIPE

CRESCENT RESOURSES, INC.
SECTION 9, RECREATION LOTS
MAP BOOK 14, PAGE 99

TOTAL AREA:
60,628 SQ.FT.

SURVEY OF:

APPROVED AUG 04 2015