IREDELL COUNTY HEALTH DEPARTMENT

STATESVILLE 704-878-5305 MOORESVILLE 704-664-5281

IMPROVEMENT PERMIT / AUTHORIZATION TO CONSTRUCT / OPERATION PERMIT / EXISTING SYSTEM INSPECTION

50.00 Sq. ft

PERMIT# 75688 PIN# 4627844939 4627-85-4346wes DATE 7/15/03

OWNER OR CONTRACTOR West Hunter PHONE: Business 3635889 Home 549-9090

ADDRESS 11800 Statesville Rd Huntersville NC 28078

LOCATION Brawley School Rd TR Blume Rd TL Beaten Path TR Ashury Circle

SUBDIVISION Shavender's Bluff BLOCK / SECTION 1530 LOT ~~155~~ LOT AREA _____ SITE CLASS. PS DESIGN FLOW 480 gpd L.T.A.R. .3

Septic Tank: 1000 Gallons; STB 312 Date 6-4-03
Pump Tank: 1000 Gallons; PT 283 Date 10-24-03
Pump Make: Myers Model M.E.50.52 Serial No. 253a5D0094
Nitrification Field: No Fields 1 Square Feet 1200' Linear Feet 400'
No Lines 6@67' Trench Width 36" Max Trench Bottom Depth 36" Gravel Depth N/A

☒ New System ☐ Repair System Type: I, II, III, IV, V, VI *
System Description: Pump - 25% Reduction *
Repair System Description: Pump - Panel
Maintenance Agreement Required: ☐ Yes ☒ No

☒ House/Mod. Home ☐ Mobile Home ☐ Business ☐ Other
No. Bedrooms 4 No. Bathrooms 4 No. Employees ____
☐ Slab ☐ Crawl Space ☐ Basement w/plumbing ☐ Basement wo/plumbing


Water Supply: ☒ Individual ☐ Public ☐ Community

Comments/Conditions: Keep Septic System at least 10' from PL 50' from lake & 100' to well Old Road bed < 15ft to drainfield must be filled


Comments/Conditions: * 25% Reduction in Drainfield Area (Plastic Chambers or EZ Flow) Checked tanks & lines 7/29/03 Lots of Rock boulders in Drainfield

Scale 1:60

INITIAL SITE SKETCH

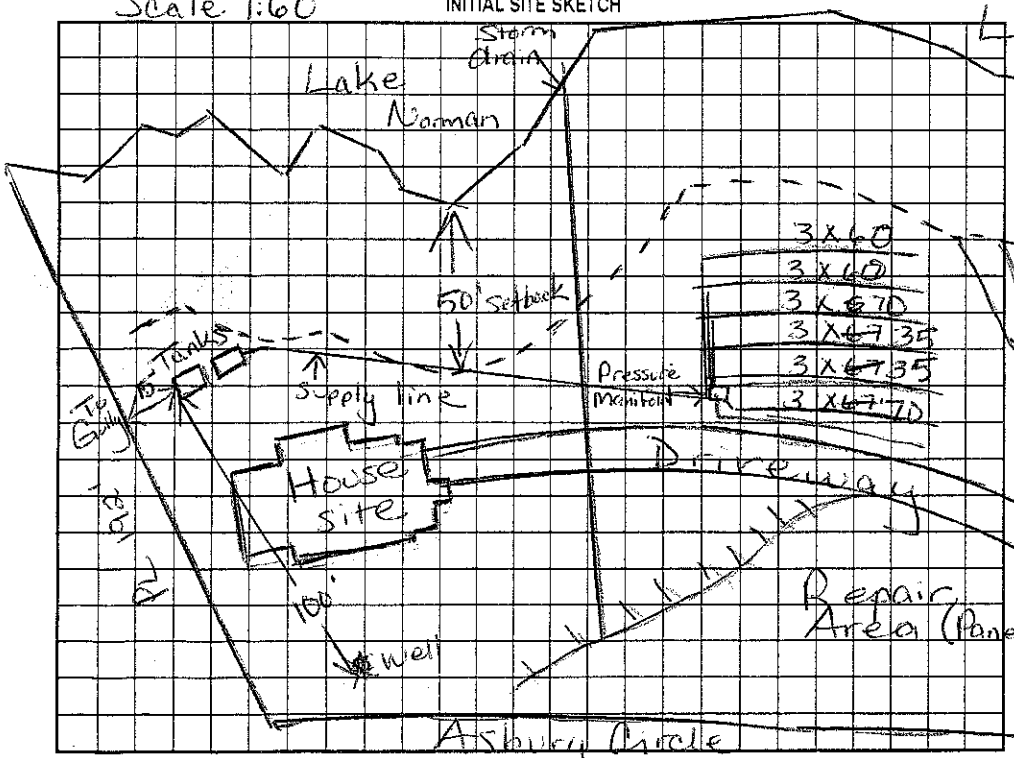

AS BUILT SKETCH

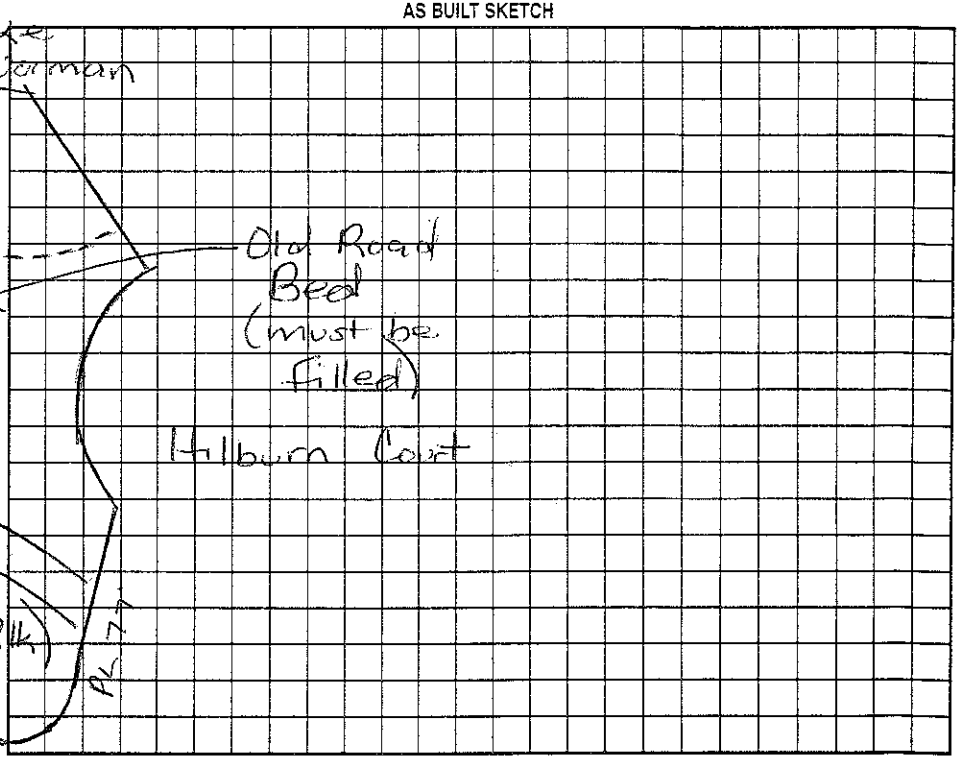

Permit can be suspended or revoked if any false information is supplied toward securing the permit/any unauthorized changes are made to the site/any unauthorized changes are made in the installation of the system. Improvement Permit with plat valid without expiration. Improvement Permit with site plan valid for sixty months. Authorization to Construct is valid for a period equal to that of Improvement Permit – not to exceed sixty months.

Signed: Hester Hunter date 7-15-03 Installed by: R&I

Improvement Permit by: Maria H.H. Dotson RS date 7/15/03 Operation Permit by: Maria H.H. Dotson RS date 7/15/03

Authorization to Construct by: Maria H.H. Dotson RS date 7/15/03 Existing System Inspection by: _____ date _____

HEALTH DEPT. COPY: WHITE OWNER COPY (FINAL): YELLOW OWNER COPY (INITIAL): PINK