IREDELL COUNTY HEALTH DEPARTMENT

STATESVILLE 704-878-5305 MOORESVILLE 704-664-5281

IMPROVEMENT PERMIT / AUTHORIZATION TO CONSTRUCT / OPERATION PERMIT / EXISTING SYSTEM INSPECTION

PERMIT# _____ PIN# 4627-85-7374 DATE Dec. 22, '98

OWNER OR CONTRACTOR Clayton A. Boggan Jr. PHONE: Business _____ Home _____

ADDRESS 3351 Paddington Lane Winston Salem 27106

LOCATION Brawley Sch Rd TR Blume TL Beaten Path. Bear Right on Asbury Circle on Right (Hilburn Dr - not constructed)

SUBDIVISION Crescent BLOCK / SECTION 9 LOT 86 LOT AREA Existing SITE CLASS. B3 easement DESIGN FLOW 360gpd L.T.A.R. .03 (repair easement)

Septic Tank: Existing Gallons; STB _____ Date _____

Pump Tank: Existing Gallons; PT _____ Date _____

Pump Make: Hydromatic Model Shef Soai Serial No. 8-97

Nitrification Field: No Fields 1 Square Feet 570-600 Linear Feet 190-200'

No Lines 5 Trench Width 36" Max Trench Bottom Depth ~30" Gravel Depth NA

☐ New System ☑ Repair System Type: I, II, III, IV, V, VI

System Description: panel block

Repair System Description: LP Panel Block

Maintenance Agreement Required: ☑ Yes ☐ No

☑ House/Mod. Home No. Bedrooms 3

☐ Mobile Home No. Bathrooms 2-3

☐ Business No. Employees _____

☐ Other _____


☐ Slab ☐ Crawl Space ☐ Basement w/plumbing ☐ Basement wo/plumbing

Water Supply: ☑ Individual ☐ Public ☐ Community


Comments:/Conditions: Existing pump will likely have to be replaced to access repair easement area w/ proper head. Recommend 3" sch 40 supply line to offsite easement. Copy of DOT easement to be supplied to this department. Mount electrical hookup on outside of pt. riser or on separate post.

Comments:/Conditions:

INITIAL SITE SKETCH NOT TO SCALE

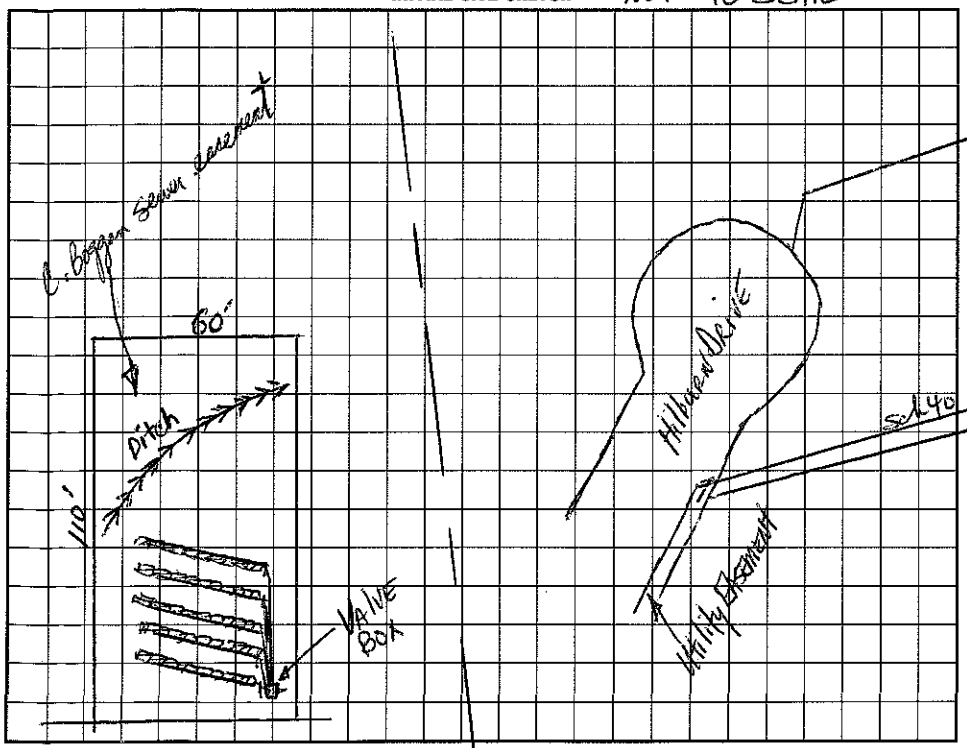

AS BUILT SKETCH

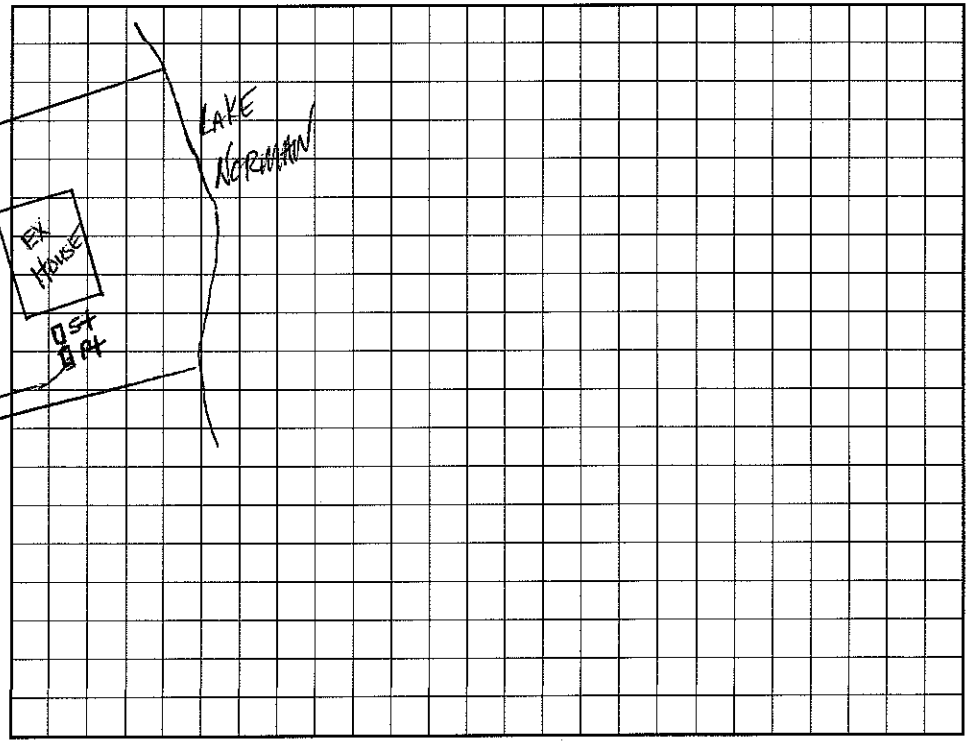

I understand that this permit can be suspended or revoked if any false information is supplied toward securing the permit/any unauthorized changes are made to the site/any unauthorized changes are made in the installation of the system. Improvement Permit with plat valid without expiration. Improvement Permit with site plan valid for sixty months. Authorization to Construct is valid for a period equal to that of Improvement Permit – not to exceed sixty months.

Signed: _____ date 1-4-99

Improvement Permit by: _____ date 12-22-98

Authorization to Construct by: _____ date 12-22-98

Installed by: Tim Cammon

Operation Permit by: Wesley Sparks R.S. date 3/18/99

Existing System Inspection by: _____ date _____

HEALTH DEPT. COPY: WHITE INSPECTION COPY (FINAL): GREEN OWNER COPY (FINAL): YELLOW INSPECTION COPY (INITIAL): PINK OWNER COPY (INITIAL): GOLD