IREDELL COUNTY HEALTH DEPARTMENT

STATESVILLE 704-878-5305 MOORESVILLE 704-664-5281

4627 86 2738

IMPROVEMENT PERMIT / CERTIFICATE OF COMPLETION / OPERATION PERMIT / EXISTING SYSTEM INSPECTION

PROPERTY DESCRIPTION NO. 24496 DATE 9/3/96 TAX MAP NO. 2L 6A 127C Watershed: [X] Yes [ ] No

OWNER OR CONTRACTOR Bridgewater Company/CL+T PHONE: Business 948-1555 Home

ADDRESS 8612 Stockton Farm Rd. Huntersville, NC. 28078

LOCATION Green Bay Rd. 150 W TL Paradise Penn TL Green Bay, 5th on (R) past Hagen Ln.

SUBDIVISION CL+T BLOCK / SECTION 10 LOT 127C LOT AREA ~2.7 AC SITE CLASS. PS DESIGN FLOW 480 L.T.A.R. .3

Septic Tank: 1500 Gallons; STB 797 Date 10-18-97
Pump Tank: 1000 Gallons; PT 27 Date 10-20 97
Pump Make: HYDROMATIC Model SK50A1 Serial No. 9/97
Nitrification Field: No Fields 1 Square Feet 1600 Linear Feet *400
No Lines 4 (5) Trench Width 36" Max Trench Bottom Depth 36" Gravel Depth SAND

[X] New System [ ] Repair System Type: I, II, (III), IV, V, VI
System Description: *PRES-CH PLASTIC
Repair System Description: ~~SAME~~ 16" PPBS
Maintenance Agreement Required: [ ] Yes [X] No

[ ] House/Mod. Home [ ] Mobile Home [ ] Business [ ] Other
No. Bedrooms 4 No. Bathrooms 3 No. Employees


[ ] Slab [ ] Crawl Space [X] Basement w/plumbing [ ] Basement wo/plumbing

Water Supply: [X] Individual [ ] Community [ ] Public

Comments: *25% reduction in linear footage
Tanks & lines checked. 12/3/97 MP

Comments: 5 lines at 80' to meet setback for well.

INITIAL SITE SKETCH 1" = 100'

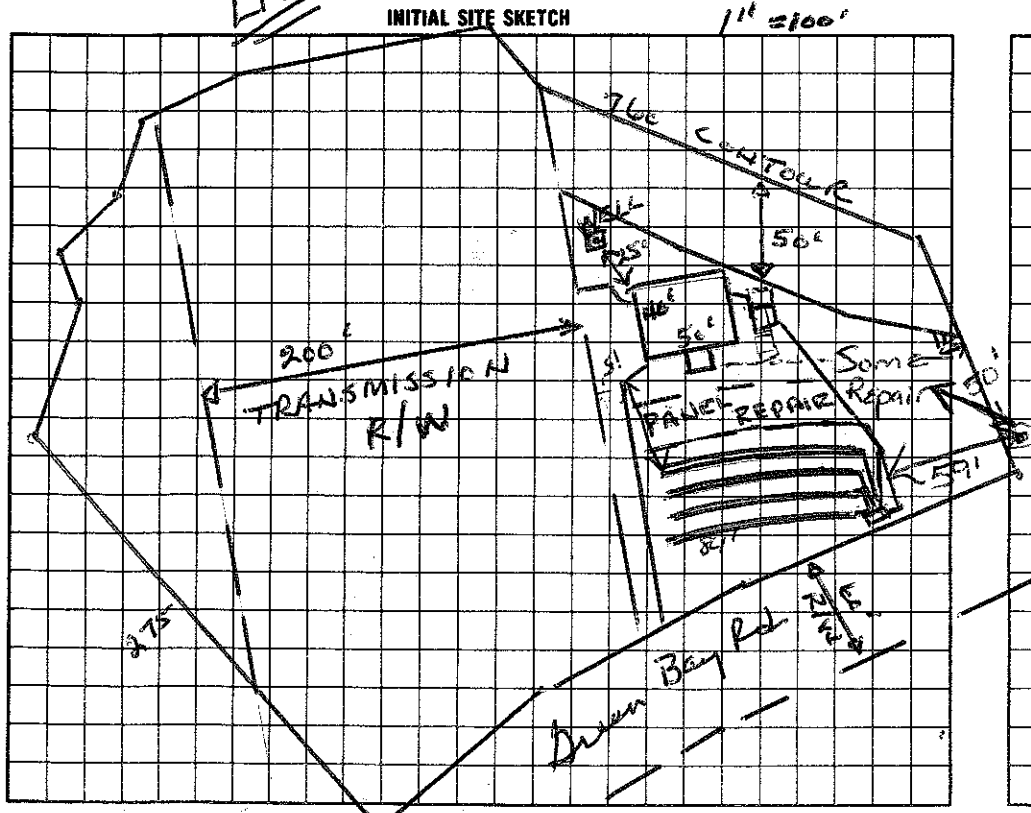

AS BUILT SKETCH

I understand that this permit can be suspended or revoked if any false information is supplied toward securing the permit/any unauthorized changes are made to the site/any unauthorized changes are made in the installation of the system.

Signed: * [signature]

Improvement Permit by: Wesley Sparks R.S. date 9/3/96

Existing System Inspection by: Wesley Sparks R.S. date 9/3/96

Installed by: Wayne Orbison

Certificate of Completion by: Wesley Sparks R.S. date 5/26/98

Operation Permit by: Wesley Sparks R.S. date 5/26/98

HEALTH DEPT. COPY: WHITE INSPECTION COPY (FINAL): GREEN OWNER COPY (FINAL): YELLOW INSPECTION COPY (INITIAL): PINK OWNER COPY (INITIAL): GOLD