IREDELL COUNTY HEALTH DEPARTMENT

STATESVILLE 704-878-5305 — MOORESVILLE 704-664-5281

150.00 Paid

IMPROVEMENT PERMIT / AUTHORIZATION TO CONSTRUCT / OPERATION PERMIT / EXISTING SYSTEM INSPECTION

PERMIT# 131739 PIN# 4627 86 8726.000 DATE 10/14/05

OWNER OR APPLICANT Clifton Lefford PHONE: Business 812-858-8504 Home

ADDRESS 118 Norgaston Ln. Mooresville NC. 28117

LOCATION 150W TL Poreden Peninsula TL Green Bay TR Norcross to last lot on R

SUBDIVISION CL+T BLOCK / SECTION 10 LOT 116 LOT AREA .58 SITE CLASS. PS DESIGN FLOW 360 L.T.A.R.

Septic Tank: 1000 Gallons; STB GST 1160 Date 9/2/05

Pump Tank: Gallons; PT Date

Pump Make: Model Serial No.

Nitrification Field: No Fields Square EXISTING Linear Feet

No Lines Trench Width Max Trench Bottom Depth Gravel Depth ☐ Gravity ☐ Pressure

☐ New System ☐ Repair ☒ Expansion System Type: I II III IV V VI

System Description: Add New Septic Tank

Repair System Description:

Maintenance Agreement Required: ☐ Yes ☒ No

☒ House/Mod. Home ☐ Mobile Home ☐ Business ☐ Other

No. Bedrooms 3 No. Persons 2 No. Employees


Water Supply: ☒ Individual ☐ Public ☐ Community

☐ Slab ☐ Crawl Space ☒ Basement w/plumbing ☐ Basement wo/plumbing


Comments:/Conditions: Add new Septic Tank in location shown here; Reconnect to Drainfield as shown.

Comments:/Conditions:

INITIAL SITE SKETCH

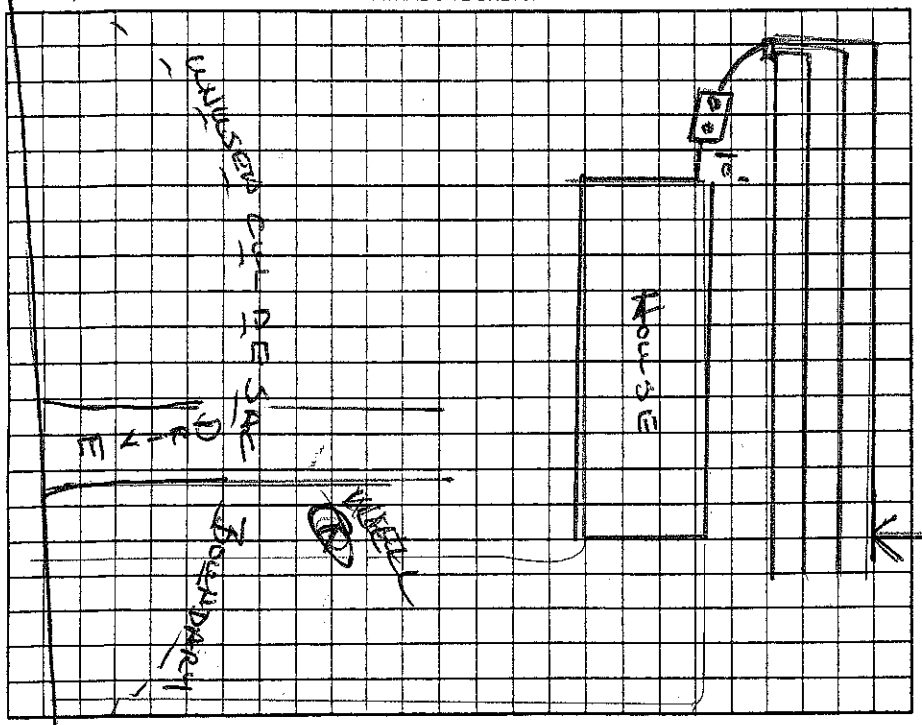

AS BUILT SKETCH

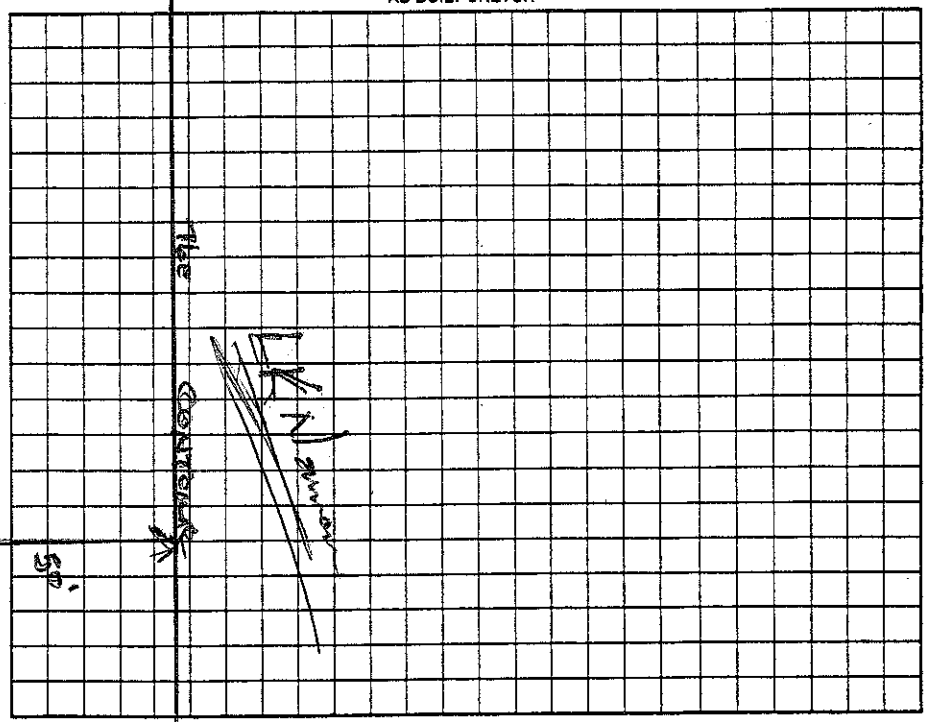

Not drawn by.

Permit can be suspended or revoked if any false information is supplied toward securing the permit/any unauthorized changes are made to the site/any unauthorized changes are made in the installation of the system. Improvement Permit with plat valid without expiration ☐ ~~Improvement Permit with site plan valid for sixty months ☐~~ Authorization to Construct is valid for a period equal to that of Improvement Permit – not to exceed sixty months.

Signed: Bridget Adkins date 10/17/05

Improvement Permit by: Wesley Sparks RS date 10/14/05

Authorization to Construct by: Wesley Sparks RS date 10/14/05

Installed by: Shane Jarrett

Operation Permit by: Wesley Sparks RS date 11/9/05

Existing System Inspection by: date

HEALTH DEPT. COPY: WHITE OWNER COPY (FINAL): YELLOW OWNER COPY (INITIAL): PINK

IREDELL COUNTY HEALTH DEPARTMENT

STATESVILLE 704-878-5305 MOORESVILLE 704-664-5281

IMPROVEMENT PERMIT / CERTIFICATE OF COMPLETION / OPERATION PERMIT / EXISTING SYSTEM INSPECTION

PROPERTY DESCRIPTION NO. Repair DATE 5/8/96 TAX MAP NO. Watershed: ☑ Yes ☐ No

OWNER OR CONTRACTOR Clifton Sifford PHONE: Business Home 663-3021

ADDRESS 118 Norcross Lane Mooresville, NC 28115

LOCATION 150 W - TL Quiet Cove - IR Ridgetop - TL Norcross - #118 Norcross Ln.

SUBDIVISION — BLOCK / SECTION — LOT LOT AREA SITE CLASS. PS DESIGN FLOW 360gpd L.T.A.R. .3 gpd/ft²

Septic Tank: 1000 Gallons; STB Date

Pump Tank: Gallons; PT Date

Pump Make: Model Serial No.

Nitrification Field: No Fields 1 Square Feet 1200 Linear Feet 400

No Lines 4 Trench Width 36" Max Trench Bottom Depth 26" Gravel Depth 12"

☐ New System ☑ Repair System Type: I (II) III, IV, V, VI

System Description: Gravity Conventional

Repair System Description:

Maintenance Agreement Required: ☐ Yes ☑ No

☑ House/Mod. Home No. Bedrooms 3

☐ Mobile Home No. Bathrooms 2

☐ Business No. Employees

☐ Other


☐ Slab ☑ Crawl Space ☐ Basement w/plumbing ☐ Basement wo/plumbing

Water Supply: ☑ Individual ☐ Community ☐ Public

Comments: New tank needs to be placed and ran to new lines. Old system needs to be abandoned.

Comments:

INITIAL SITE SKETCH

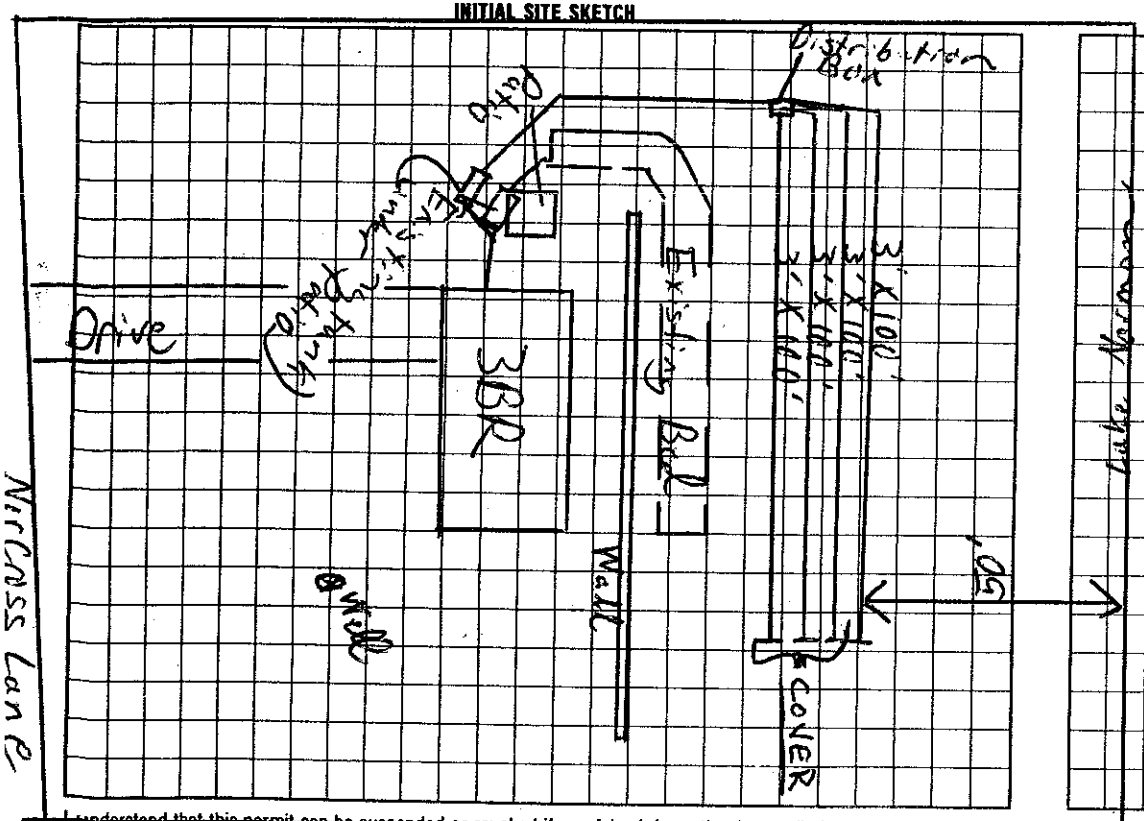

AS BUILT SKETCH

I understand that this permit can be suspended or revoked if any false information is supplied toward securing the permit/any unauthorized changes are made to the site/any unauthorized changes are made in the installation of the system.

Signed: Kathryn J. Sifford

Improvement Permit by: C. Beth Teem EHSI date 5/8/96

Authorization to Construct Existing System Inspection by: C. Beth Teem EHSI date 5/8/96

Installed by: Tim Ammons

Certificate of Completion by: date

Operation Permit by: Wesley Sparks RS. date 6/19/96

HEALTH DEPT. COPY: WHITE INSPECTION COPY (FINAL): GREEN OWNER COPY (FINAL): YELLOW INSPECTION COPY (INITIAL): PINK OWNER COPY (INITIAL): GOLD