IREDELL COUNTY HEALTH DEPARTMENT

STATESVILLE 704-878-5305 MOORESVILLE 704-664-5281

IMPROVEMENT PERMIT / CERTIFICATE OF COMPLETION / OPERATION PERMIT / EXISTING SYSTEM INSPECTION

PROPERTY DESCRIPTION NO. Repair DATE 5/8/96 TAX MAP NO. 4627868726 Watershed: ☑ Yes ☐ No

OWNER OR CONTRACTOR Clifton Sifford PHONE: Business Home 663-3021

ADDRESS 118 Norcross Lane Mooresville, NC 28115

LOCATION 150 W - TL Quiet Cove - TR Ridgetop - TL Norcross - #118 Norcross Ln.

SUBDIVISION — BLOCK / SECTION — LOT LOT AREA SITE CLASS. PS DESIGN FLOW 360gpd L.T.A.R. .3 gpd/sqft

Septic Tank: 1000 Gallons; STB Date

Pump Tank: Gallons; PT Date

Pump Make: Model Serial No.

Nitrification Field: No Fields 1 Square Feet 1200 Linear Feet 800

No Lines 4 Trench Width 36" Max Trench Bottom Depth 24" Gravel Depth 12"

☐ New System ☑ Repair System Type: I (II) III, IV, V, VI

System Description: gravity Conventional

Repair System Description:

Maintenance Agreement Required: ☐ Yes ☑ No

☑ House/Mod. Home No. Bedrooms 3

☐ Mobile Home No. Bathrooms 2

☐ Business No. Employees

☐ Other


☐ Slab ☑ Crawl Space ☐ Basement w/plumbing ☐ Basement wo/plumbing

Water Supply: ☑ Individual ☐ Community ☐ Public

Comments: New tank needs to be placed and run to new lines. Old system needs to be abandoned.

Comments:

INITIAL SITE SKETCH

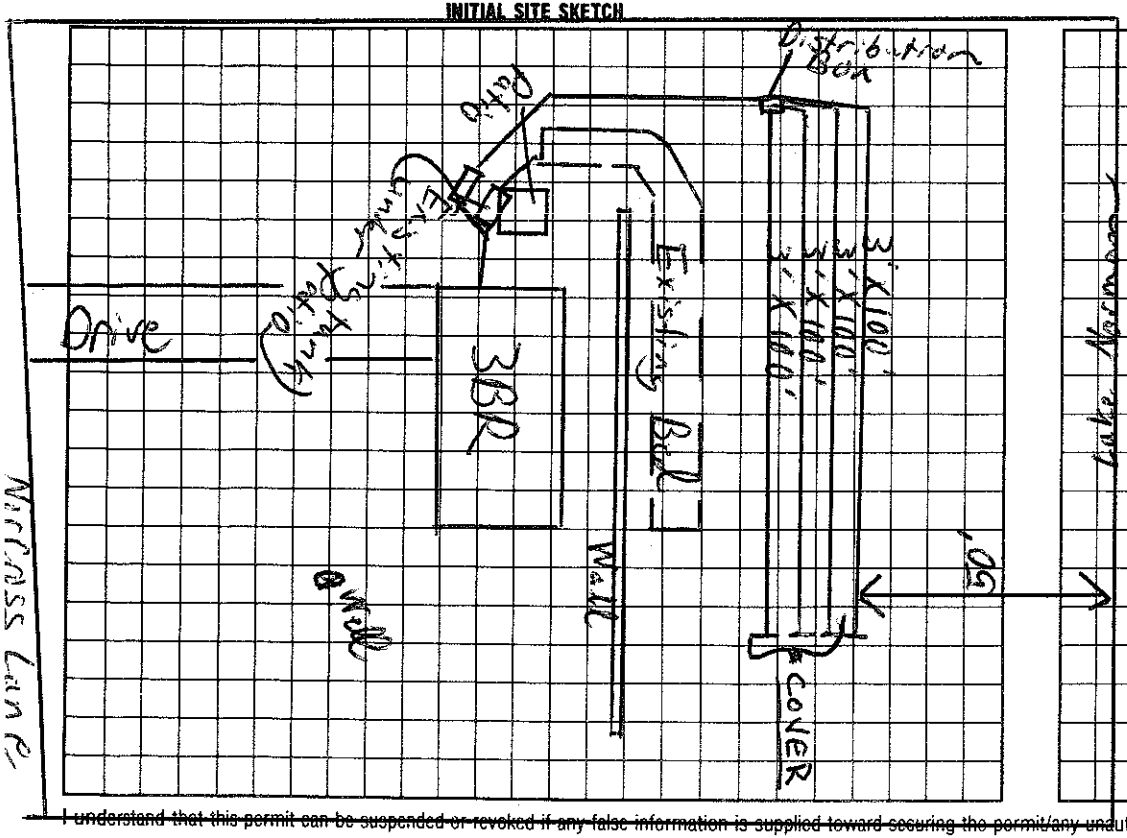

AS BUILT SKETCH

I understand that this permit can be suspended or revoked if any false information is supplied toward securing the permit/any unauthorized changes are made to the site/any unauthorized changes are made in the installation of the system.

Signed: Kathryn J. Sifford

Installed by: Tim Simmons

Improvement Permit by: C. Ruby Freeman EHSI date 5/15/96

Authorization to Construct

Existing System Inspection by: C. Ruby Freeman EHSI date 5/15/96

Certificate of Completion by: date

Operation Permit by: Wesley Sparks RS. date 6/19/96

HEALTH DEPT. COPY: WHITE INSPECTION COPY (FINAL): GREEN OWNER COPY (FINAL): YELLOW INSPECTION COPY (INITIAL): PINK OWNER COPY (INITIAL): GOLD