IREDELL COUNTY HEALTH DEPARTMENT

Statesville Office (704) 878-5305 Mooresville Office (704) 660-3625 PERMIT # 22|524

IMPROVEMENT PERMIT / AUTHORIZATION TO CONSTRUCT / OPERATION PERMIT / EXISTING SYSTEM

PIN # 4627-87-4180

APPLICANT: FREEDOM HOMES APPLICANT ADDRESS: 1124 CHARLOTTE HWY. TROUTMAN

SITE ADDRESS: 342 GREENBAY RD. MOORESVILLE PHONE: 704-876-5866 ALT. PHONE:

SITE DIRECTIONS: 150, TL QUIET COVE, TR RIDGETOP, GREENBAY, ON R

SUBDIVISION: CLET SECTION: 10 LOT # 125 LOT AREA: .75 AC DESIGN FLOW: 360 L.T.A.R.: .3

Septic Tank 1000 (gal) STB Date

Pump Tank (gal) PT Date

Pump Make Model Serial #

Nitrification Fields 1 # Lines 4 Linear Ft: 117'

Trench Width 36" Max. Trench Bottom Depth 30" Low side Gravel Depth —

☐ New System ☐ Repair ☒ Expansion System Type: I II (III) IV V VI

System Description: GRAVEL + 25% REDUCTION

Repair System Description: PANEL BLOCK

Maintenance Agreement Required: ☐ YES ☒ NO

☒ GRAVITY ☐ PRESSURE

☒ Residence ☐ Business ☐ Other ☐ Slab ☒ Crawl Space ☐ Basement w/plumbing


No. Bedrooms 3 No. Persons 6 No. Employees

Water Supply: ☒ Private Ex. ☐ Public ☐ Community


☐ Basement w/o plumbing

Comments / Conditions: OLD TANK CAN BE PUMPED, CRUSHED & FILLED (RECOMENDED) BUT MUST HAVE NEIGHBOR'S PERMISSION. Installed Infiltrator SJ

INITIAL SITE SKETCH

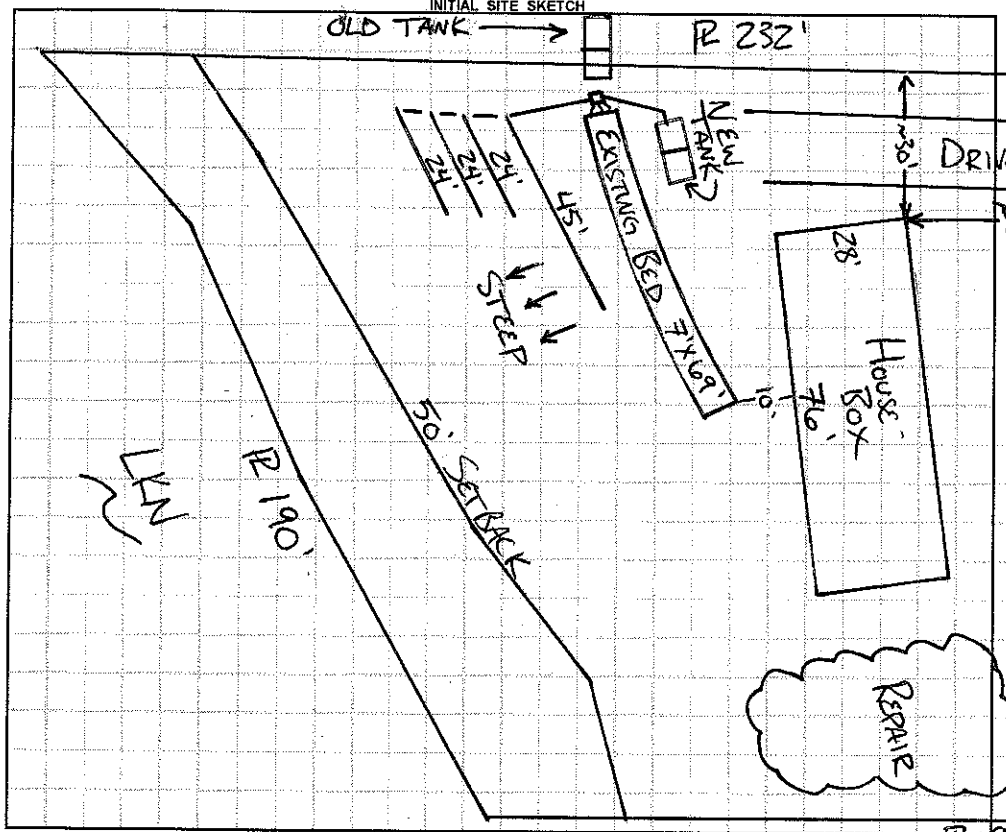

AS BUILT SKETCH

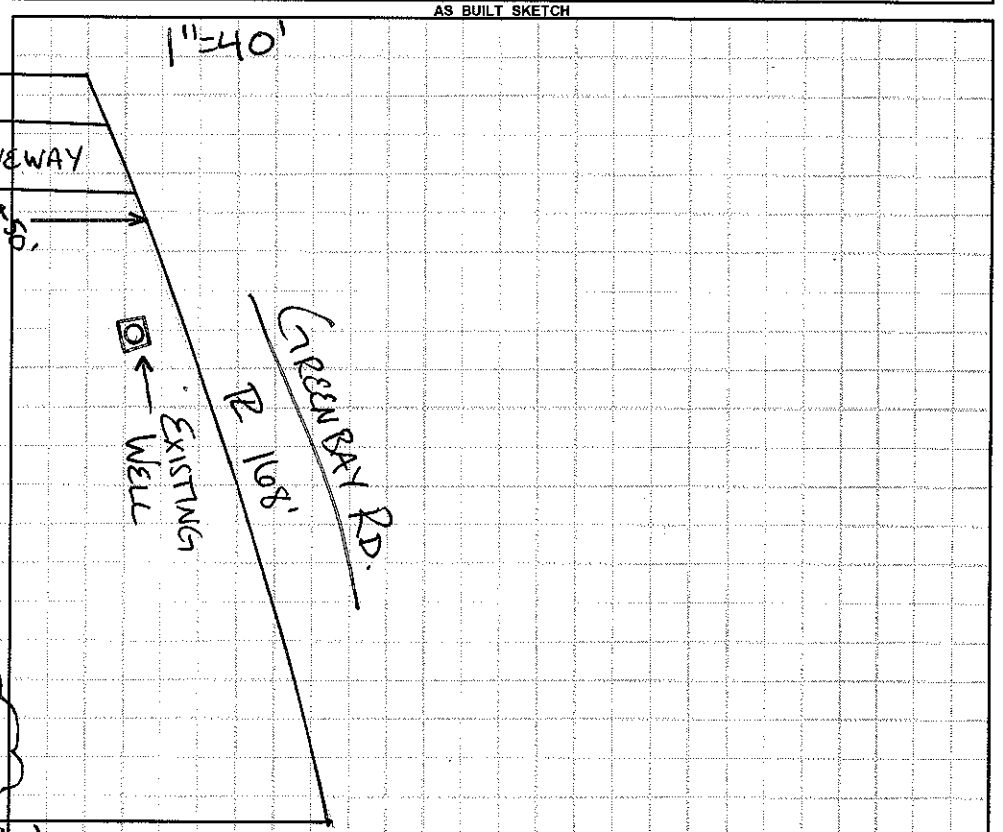

Permit can be suspended or revoked if any false information is supplied toward securing the permit / any unauthorized changes are made to the site / any unauthorized changes are made in the installation of the system. **CONTACT A LOCATOR SERVICE PRIOR TO ANY EXCAVATION**

☐ **IMPROVEMENT PERMIT** *with plat valid without expiration.* ☒ **IMPROVEMENT PERMIT** *with site plan valid for 60 mos.* ☒ **AUTHORIZATION TO CONSTRUCT** *valid for period equal to IMPROVEMENT PERMIT--not to exceed 60 mo.*

Owner / Applicant Signature: Kimberly Freed Date: 11-9-16 Installed by: Tommy Frye

IMPROVEMENT PERMIT by: RA Date: 11-7-16 OPERATION PERMIT by: Marvin Dolan Date: 12/30/16

AUTHORIZATION TO CONSTRUCT by: RA Date: 11-7-16 Existing System Inspected by: Date:

Health Dept. Copy - WHITE Applicant (Final Approval) - YELLOW Applicant (Conditional Approval) - PINK