IREDELL COUNTY HEALTH DEPARTMENT

STATESVILLE 704-878-5305 MOORESVILLE 704-664-5281

IMPROVEMENT PERMIT / AUTHORIZATION TO CONSTRUCT / OPERATION PERMIT / EXISTING SYSTEM INSPECTI N

PERMIT# 113387 PIN# 4627-88-5496.000 - 4627-88-1307 DATE Sept. 10, 03

OWNER OR CONTRACTOR Bridgewater LLC / GREENBAY FOREST LLC / EDWARDS Phone-Business Home

ADDRESS P.O. Box 3608, Mooresville, N.C. 28117

LOCATION BD WEST TL Paradise Peninsula TL Greenbay

SUBDIVISION GREENBAY FOREST BLOCK / SECTION LOT 8 LOT AREA * 2.06 AC / SITE CLASS. B5 DESIGN FLOW 480gpd L.T.A.R. .3

Septic Tank: 1000 Gallons; STB 794 Date 5/18/04
Pump Tank: 1000 Gallons; PT 27 Date w/ 30/04
Pump Make: GOULDS Model WE0311M Serial No G04605799
Nitrification Field: No Fields 1 Square Feet 1200 Linear Feet 400
No Lines 4 Trench Width 36" Max Trench Bottom Depth 36"


☑ New System ☐ Repair System Type: I, II, III, IV, V, VI
System Description: PM 25% Reduction
Repair System Description: LP 25% Reduction
Maintenance Agreement Required: ☐ Yes ☑ No initially
Gravel Depth N/R

☑ House/Mod. Home No. Bedrooms 4/4
☐ Mobile Home No. Bathrooms 4/4
☐ Business No. Employees
☐ Other
☐ Slab ☑ Crawl Space ☐ Basement w/plumbing ☐ Basement wo/plumbing

Water Supply: ☑ Individual ☐ Public ☐ Community


Comments:/Conditions:
* Approx 1 Ac in Duke Power RW

INITIAL SITE SKETCH

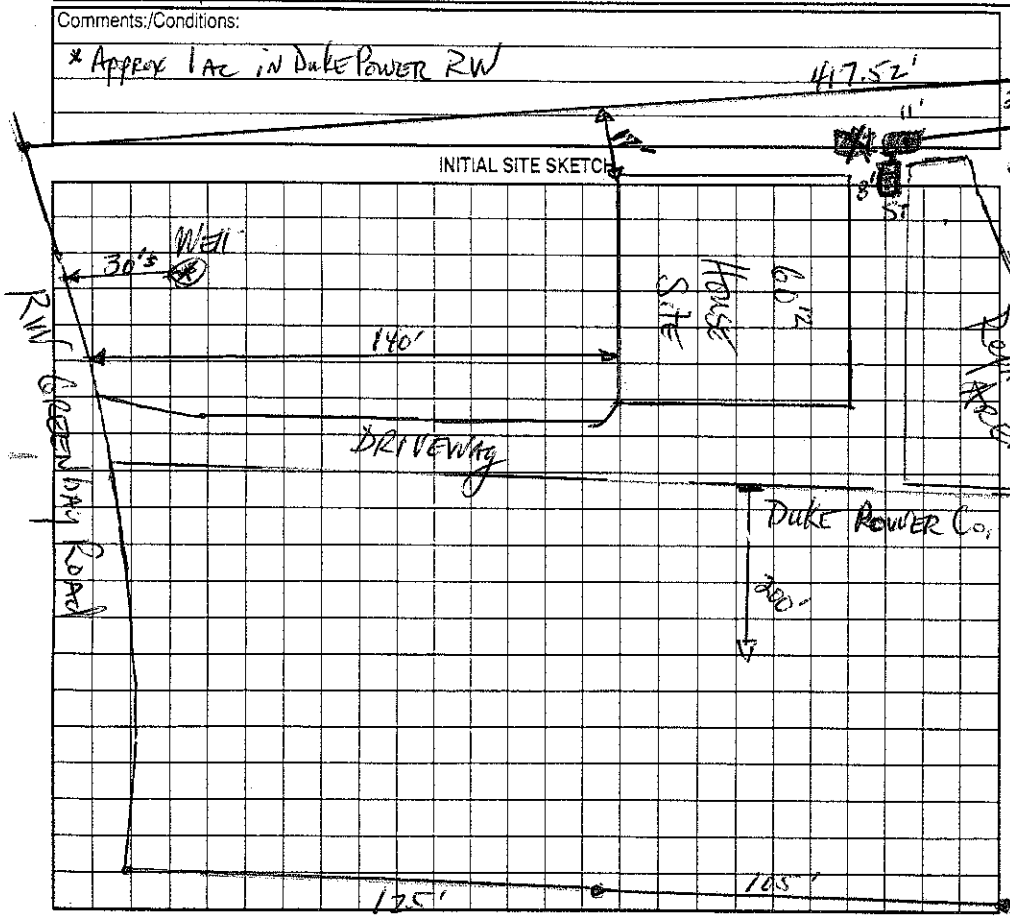

Comments:/Conditions:
4" sch 80 pvc (4" trps)
2" sch 40

AS BUILT SKETCH

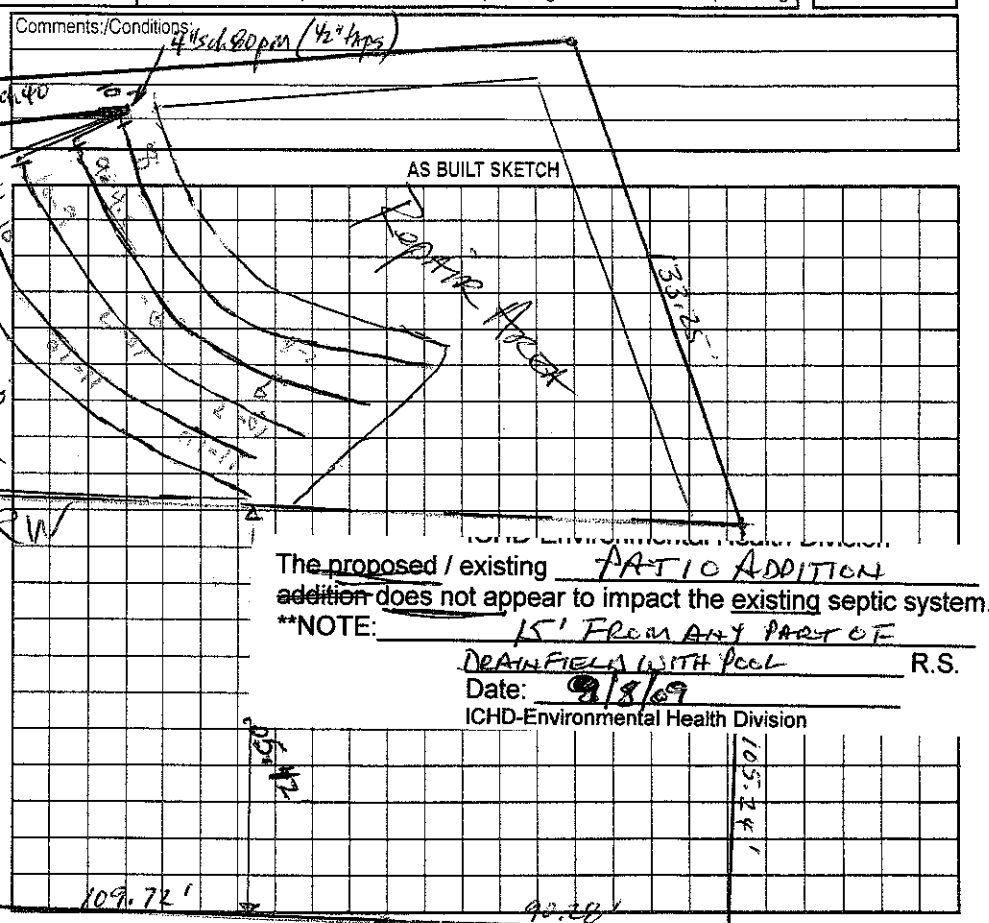

The proposed / existing PATIO ADDITION addition does not appear to impact the existing septic system.
**NOTE: 15' FROM ANY PART OF DRAINFIELD WITH POOL R.S.
Date: 9/8/09
ICHD-Environmental Health Division

Permit can be suspended or revoked if any false information is supplied toward securing the permit/any unauthorized changes are made to the site/any unauthorized changes are made in the installation of the system. Improvement Permit with plat valid without expiration. Improvement Permit with site plan valid for sixty months. Authorization to Construct is valid for a period equal to that of Improvement Permit – not to exceed sixty months.

Signed: date 10-30-03 Installed by: Marty Tucker

Improvement Permit by: PS date 9-10-03 Operation Permit by: RS date 12/9/04

Authorization to Construct by: W Sparks R.S. date 3/17/04 Existing System Inspection by: date

HEALTH DEPT. COPY: WHITE OWNER COPY (FINAL): YELLOW OWNER COPY (INITIAL): PINK