4627-89-1211

IREDELL COUNTY HEALTH DEPARTMENT

STATESVILLE 704-878-5305 MOORESVILLE 704-664-5281

IMPROVEMENT PERMIT / AUTHORIZATION TO CONSTRUCT / OPERATION PERMIT / EXISTING SYSTEM INSPECTION

PERMIT# 075621 PIN# 4726889970 PT Jerry Atkinson DATE 6/28/2000

OWNER OR CONTRACTOR CRI - David Green PHONE: Business 336-787-3139 Home 336 247-1343

ADDRESS P.O. Box 1003 Charlotte NC 28201

LOCATION Hwy 150 W. TL Paradise Peninsula TL Reed Brooke LN

SUBDIVISION Pinnacle Shores BLOCK / SECTION 4 LOT 12a 11/11A LOT AREA SITE CLASS. PS DESIGN FLOW 480gpd L.T.A.R. .3 to .25

Septic Tank: 1000 Gallons; STB 794 Date 3/5/01

Pump Tank: 1000 Gallons; PT 27 Date 3/9/01

Pump Make Goulds Model WE05IH Serial No. 5027602G

Nitrification Field: No Fields 1 Square Feet 1440' Linear Feet 480'

No Lines 8 at 60' Trench Width 36" Max Trench Bottom Depth 36" Gravel Depth N/A

☒ New System ☐ Repair System Type: I, II, III, IV, V, VI

System Description: Pump-PM-25% Reduction OFFSITE

Repair System Description: Lot 11A - LP Panel Blk

Maintenance Agreement Required: ☐ Yes ☒ No

☒ House/Mod. Home ☐ Mobile Home ☐ Business ☐ Other

No. Bedrooms 4/4 No. Bathrooms 4/4 No. Employees

Water Supply: ☐ Individual ☒ Public ☒ Community

☐ Slab ☐ Crawl Space ☒ Basement w/plumbing ☐ Basement wo/plumbing


Comments:/Conditions:

★ Repair located offsite on 11A.

Comments:/Conditions: Keep Drainlines above rock outcrop. Keep Septic System at least 10' from PL & 5' from House. Note: May be able to use longer length drainlines & reduce number of lines

Scale 1:50'

INITIAL SITE SKETCH

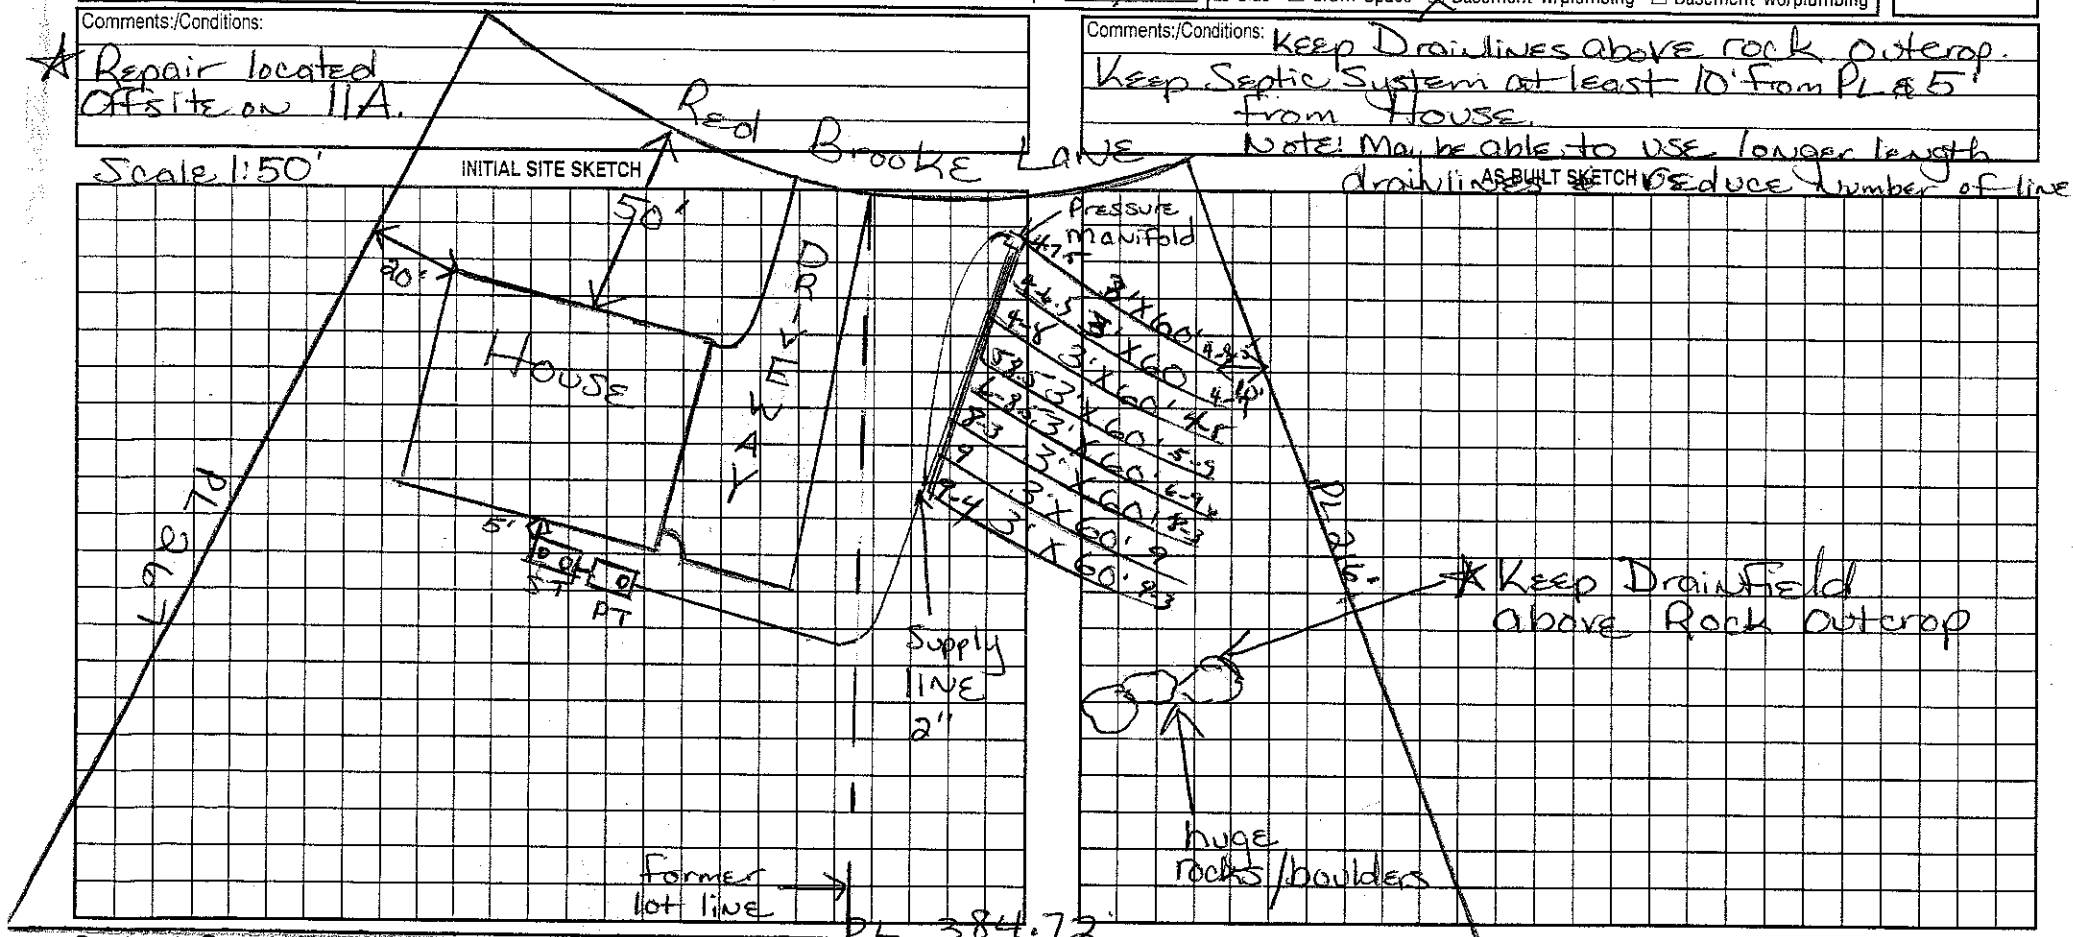

AS-BUILT SKETCH

Permit can be suspended or revoked if any false information is supplied toward securing the permit/any unauthorized changes are made to the site/any unauthorized changes are made in the installation of the system. Improvement Permit with plat valid without expiration. Improvement Permit with site plan valid for sixty months. Authorization to Construct is valid for a period equal to that of Improvement Permit – not to exceed sixty months.

Signed: Jerry A. Atkinson date 6/30/2000

Improvement Permit by: Maria H. H. Dotson RS date

Authorization to Construct by: Maria H. H. Dotson RS date

Installed by: Atlantic Grading

Operation Permit by: Cary Mabry AST date 6/6/01

Existing System Inspection by: date

HEALTH DEPT. COPY: WHITE OWNER COPY (FINAL): YELLOW OWNER COPY (INITIAL): PINK