400 5/32 3/16

IREDELL COUNTY HEALTH DEPARTMENT

STATESVILLE 704-878-5305 MOORESVILLE 704-664-5281

IMPROVEMENT PERMIT / AUTHORIZATION TO CONSTRUCT / OPERATION PERMIT / EXISTING SYSTEM INSPECTION

PERMIT# 075619 PIN# 4627889970 (pt.) 4627893196 Chris DATE 1-18-2000

OWNER OR CONTRACTOR Chris Fritts / Crescent Resources PHONE: Business 201-4115 Mobile Home

ADDRESS P.O. Box 1003 Charlotte

LOCATION Hwy 150 W. TL Paradise Peninsula TL Red Brook Ln on right. 126 Red Brook Ln

SUBDIVISION Pinnacle Shores BLOCK / SECTION 4 LOT 10 LOT AREA .77Acre SITE CLASS. PS DESIGN FLOW 360gpd L.T.A.R. .3

Septic Tank: 1000 Gallons; STB 794 Date 8-28-00
Pump Tank: 1000 Gallons; PT 283 Date 2-30-00
Pump Make: Goulds Model WE05111H Serial No. 501815168
Nitrification Field: No Fields 1 Square Feet 600' Linear Feet 200'
No Lines 4 at 50' Trench Width 36" Max Trench Bottom Depth 30"

☒ New System ☐ Repair System Type: I, II, III, IV, V, VI
System Description: Pump(PM) Paver Block*
Repair System Description: Pump(LPP) 25% Reduction
Maintenance Agreement Required: ☐ Yes ☒ No
Gravel Depth N/A


☒ House/Mod. Home ☐ Mobile Home ☐ Business ☐ Other
No. Bedrooms 3 No. Bathrooms 2 No. Employees
☐ Slab ☒ Crawl Space ☐ Basement w/plumbing ☐ Basement wo/plumbing


Water Supply: ☐ Individual ☒ Public ☒ Community

Comments:/Conditions: Keep Septic System at least 10' From PL & 5' From House. Set house at least 50' From road.

Comments:/Conditions: *50% Reduction in Drainfield Area
Riser installed
Replaces permit issued 12/17/98
Checked lower 3 liner tanks 1/4/2000 MD
Checked AS BUILT SKETCH 10/5/2000 MD
Checked Electrical box 12/22/00

INITIAL SITE SKETCH Scale 1:50

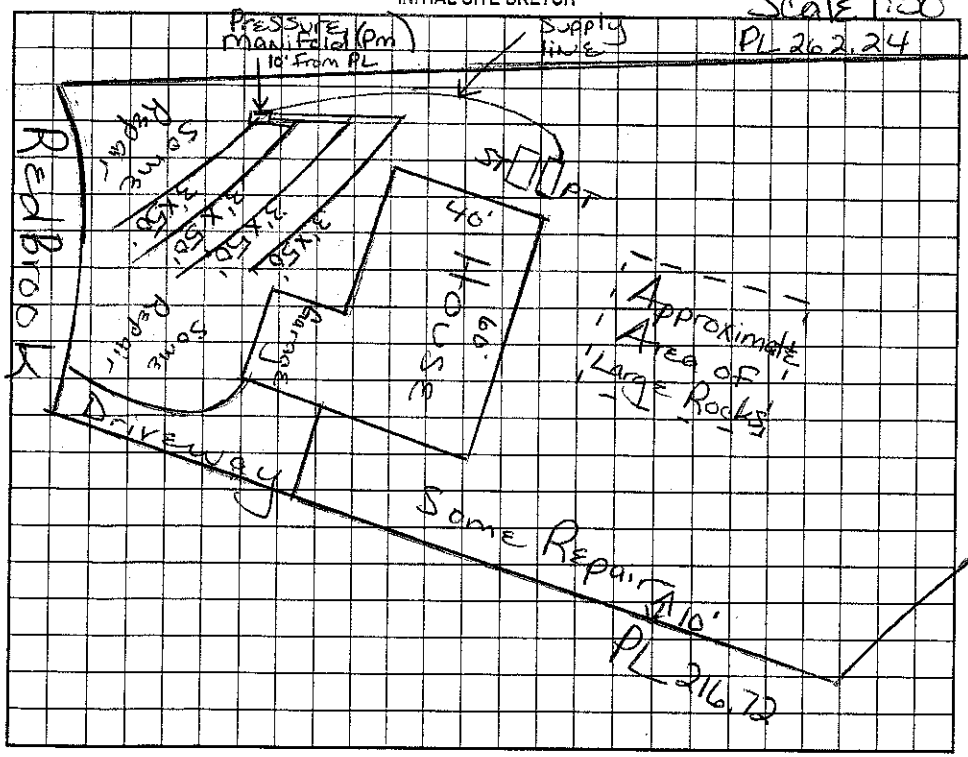

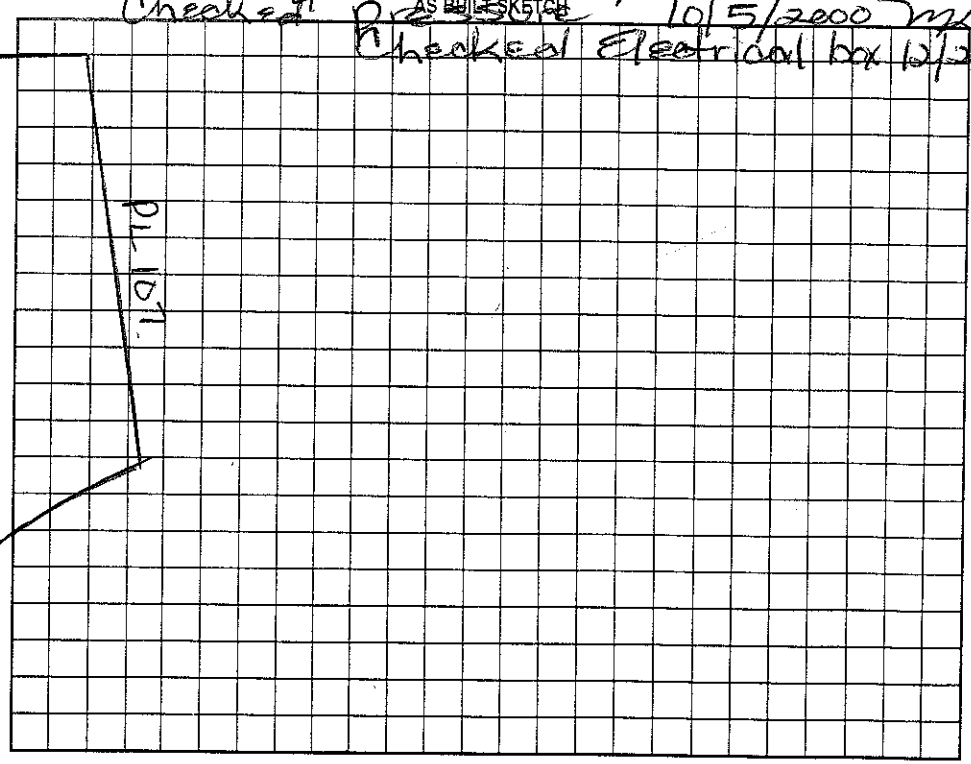

Permit can be suspended or revoked if any false information is supplied toward securing the permit/any unauthorized changes are made to the site/any unauthorized changes are made in the installation of the system. Improvement Permit with plat valid without expiration. Improvement Permit with site plan valid for sixty months. Authorization to Construct is valid for a period equal to that of Improvement Permit – not to exceed sixty months.

Signed: Chris Fritts date 2/7/00 Installed by: Dennis Hoyle

Improvement Permit by: Maria H. Dotson R.S. date 1/18/2000 Operation Permit by: Maria H. Dotson R.S. date 12/27/2000

Authorization to Construct by: Maria H. Dotson R.S. date 1/18/2000 Existing System Inspection by: date

HEALTH DEPT. COPY: WHITE OWNER COPY (FINAL): YELLOW OWNER COPY (INITIAL): PINK