IREDELL COUNTY HEALTH DEPARTMENT

STATESVILLE 704-878-5305 MOORESVILLE 704-664-5281

IMPROVEMENT PERMIT / AUTHORIZATION TO CONSTRUCT / OPERATION PERMIT / EXISTING SYSTEM INSPECTION

PERMIT# 128873 20 PIN# 4627 89 3319.000 DATE 6/24/05

OWNER OR CONTRACTOR MARC BUILDERS INC. PHONE: Business 704-226-8099 Home

ADDRESS 15930 Glenmire Dr. Huntersville, NC. 28078

LOCATION 150W TL Paradise Peninsula TL Red Brook Ln. 3RD lot on (L)

SUBDIVISION Pinnacle Shores BLOCK / SECTION 4 LOT 3 LOT AREA .69 SITE CLASS PS DESIGN FLOW 360 L.T.A.R. .3

Septic Tank: 1000 Gallons; STB 825 Date 11/16 for
Pump Tank: 1000 Gallons; PT 302 Date 12/11/05
Pump Make: Gowans Model PE-4IM Serial No.
Nitrification Field: No Fields 1 Square Feet 900 Linear Feet 300
No Lines 5 Trench Width 3' Max Trench Bottom Depth 3' Gravel Depth No

[X] New System [ ] Repair System Type: I (II) III, V, VI
System Description: Pump Men → 25% Reduced
Repair System Description: Pressured 16" PPBRS
Maintenance Agreement Required: [ ] Yes [X] No


[X] House/Mod. Home No. Bedrooms 3
[ ] Mobile Home No. Bathrooms 3.5
[ ] Business No. Employees
[ ] Other
[ ] Slab [X] Crawl Space [ ] Basement w/plumbing [ ] Basement wo/plumbing

Water Supply:
[ ] Individual
[ ] Public
[X] Community
Pinshes


Comments/Conditions: Buyer Beware: Poor Landscape position for house site. Care must be taken to not disturb drainfield area (initial + repair) Stormwater diversion 1"=30' of utmost importance.

Comments/Conditions: Fast Track by Andrea Lemon 4/26/06 Ends cut off Cording in Connection Box - need to see pump cycle to ensure wiring is correct. 228.33

INITIAL SITE SKETCH

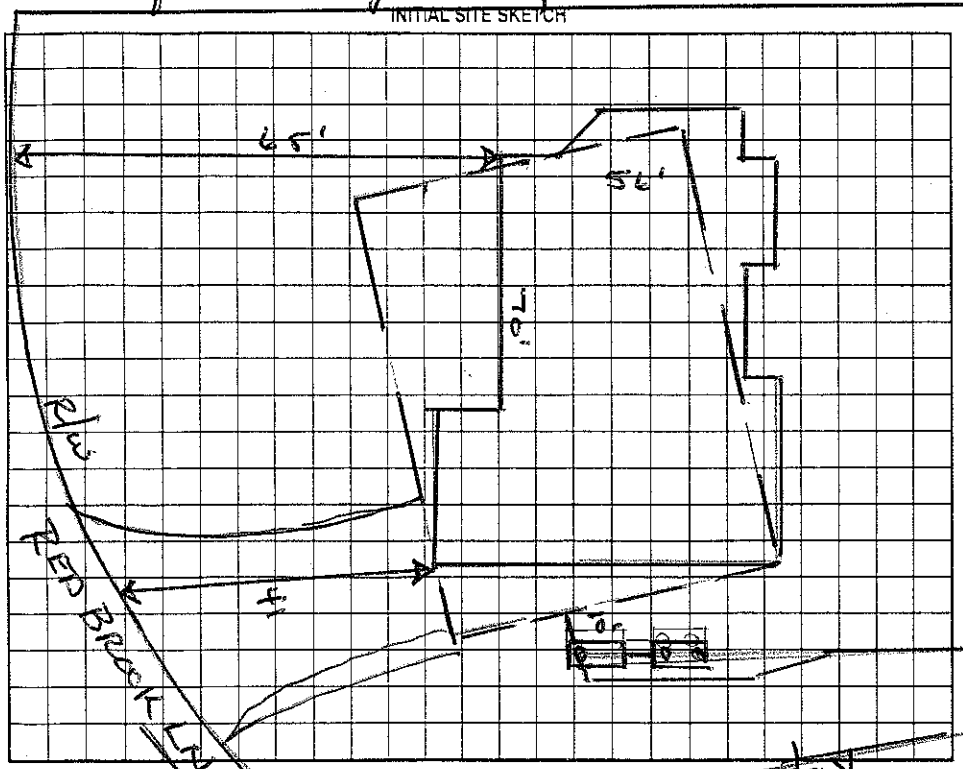

AS BUILT SKETCH

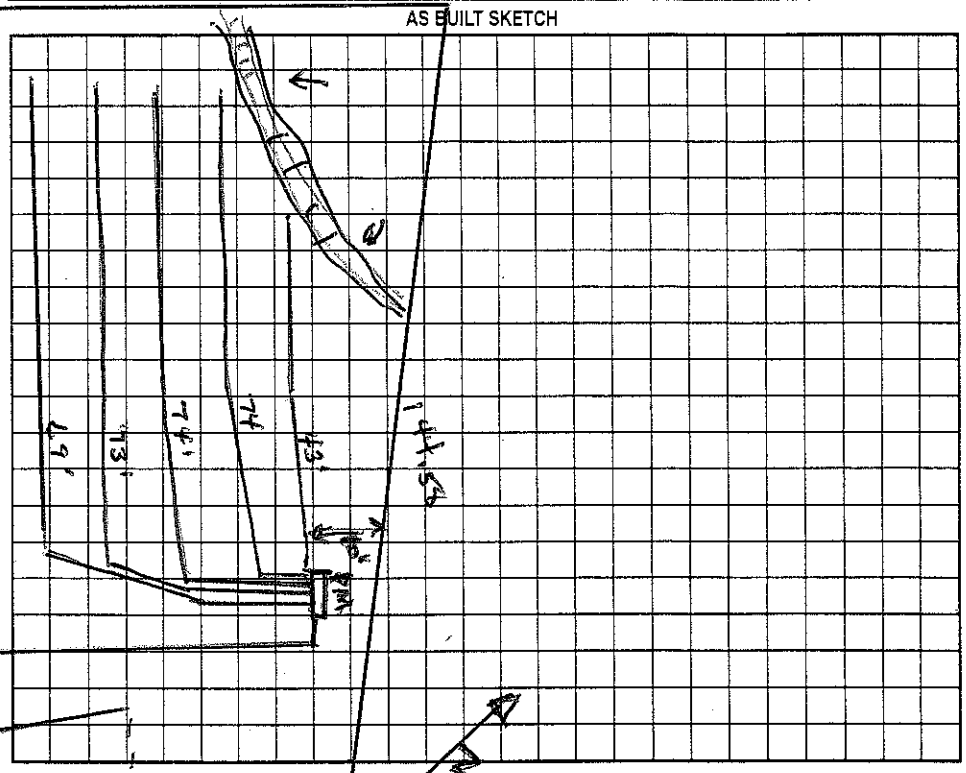

Permit can be suspended or revoked if any false information is supplied toward securing the permit, any unauthorized changes are made to the site/any unauthorized changes are made in the installation of the system. Improvement Permit with plat valid without expiration. Improvement Permit with site plan valid for sixty months. Authorization to Construct is valid for a period equal to that of Improvement Permit – not to exceed sixty months.

Signed: X date

Installed by: Rowan Septic Tanks

Improvement Permit by: Wesley Sparks RS date 6/24/05

Operation Permit by: Wesley Sparks RS date 5/1/06

Authorization to Construct by: Wesley Sparks RS date 6/24/05

Existing System Inspection by: date

HEALTH DEPT. COPY: WHITE OWNER COPY (FINAL): YELLOW OWNER COPY (INITIAL): PINK