IREDELL COUNTY HEALTH DEPARTMENT

STATESVILLE 704-878-53[illegible] MOORESVILLE 704-664-5281

IMPROVEMENT PERMIT / AUTHORIZATION TO CONSTRUCT / OPERATION PERMIT / EXISTING SYSTEM INSPECTION

PERMIT# 075618 PIN# [redacted] 4627-89-5202 DATE 9/11/03

OWNER OR CONTRACTOR Doug Haney PHONE: Business 980-721-1249 Home

ADDRESS 8545-2C Townley Rd Huntersville NC 28078

LOCATION Hwy 150 W, TL Paradise Pens., TL Red Block Ln, on Rt before Cul-de-sac

SUBDIVISION Pinnacle Shores BLOCK / SECTION 4 LOT 9 LOT AREA 0.726AC SITE CLASS. PS DESIGN FLOW 360 L.T.A.R. 0.3

Septic Tank: 1000 Gallons; STB 312 Date 3/23/04

Pump Tank: Gallons; PT Date

Pump Make: Model Serial No.

Nitrification Field: No Fields 1 Square Feet 900 Linear Feet 300

No Lines 30/100' Trench Width 36" Max Trench Bottom Depth 36" Gravel Depth —

☒ New System ☐ Repair System Type: I, II, III, IV, V, VI

System Description: Gravity 25% Reduction

Repair System Description: LP Panel Block

Maintenance Agreement Required: ☐ Yes ☒ No

☒ House/Mod. Home ☐ Mobile Home ☐ Business ☐ Other

No. Bedrooms 3 No. Bathrooms 2½ No. Employees

☐ Slab ☒ Crawl Space ☒ Basement w/plumbing ☐ Basement wo/plumbing


Water Supply: ☐ Individual ☐ Public ☒ Community

Comments:/Conditions:


1"=40'

Comments:/Conditions:

INITIAL SITE SKETCH

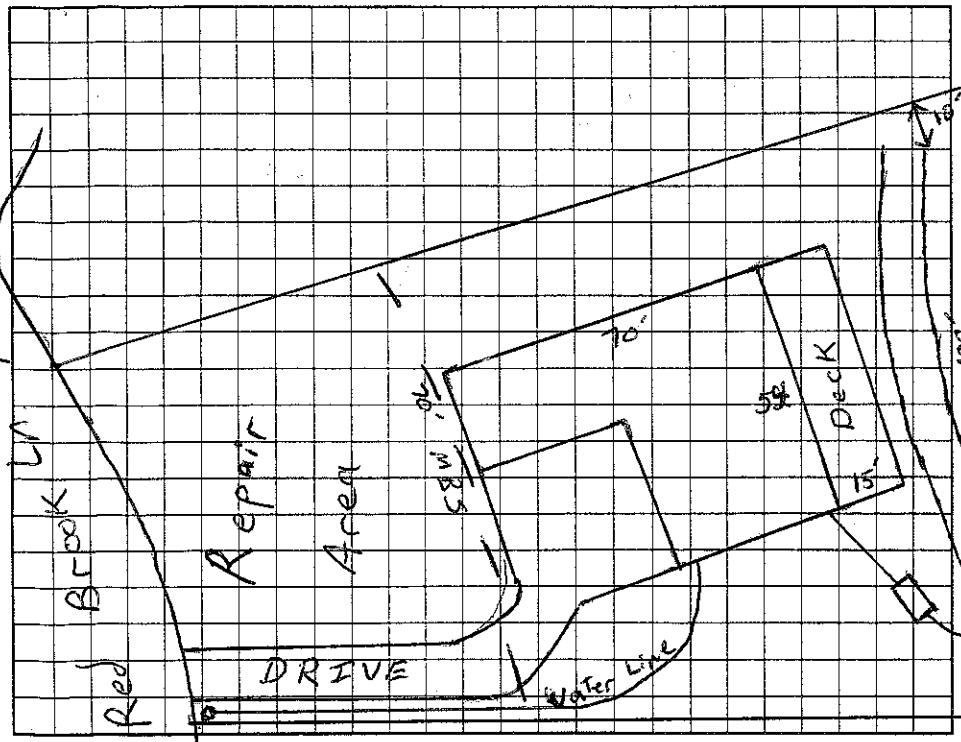

AS BUILT SKETCH

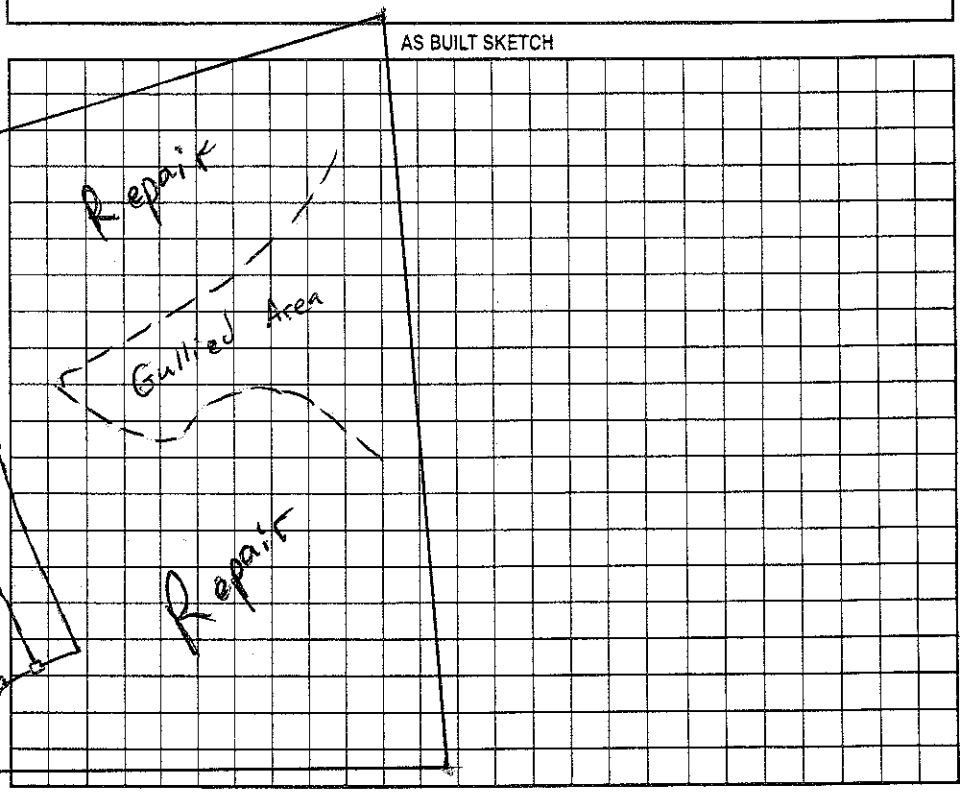

Permit can be suspended or revoked if any false information is supplied toward securing the permit/any unauthorized changes are made to the site/any unauthorized changes are made in the installation of the system. Improvement Permit with plat valid without expiration. Improvement Permit with site plan valid for sixty months. Authorization to Construct is valid for a period equal to that of Improvement Permit – not to exceed sixty months.

Signed: Doug Haney date 9/11/03 Installed by: Richard Abernathy

Improvement Permit by: RS date 9/11/03 Operation Permit by: Wesley Sparks R.S. date 6/3/04

Authorization to Construct by: RS date 9/11/03 Existing System Inspection by: date

HEALTH DEPT. COPY: WHITE OWNER COPY (FINAL): YELLOW OWNER COPY (INITIAL): PINK