IREDELL COUNTY HEALTH DEPARTMENT - ENVIRONMENTAL HEALTH ☐ STATESVILLE OFFICE 704-878-5305 ☐ MOORESVILLE OFFICE 704-664-528

IMPROVEMENT PERMIT / AUTHORIZATION TO CONSTRUCT / OPERATION PERMIT / EXISTING SYSTEM INSPECTION

PERMIT # ~~H3345~~ 11607066 PIN # ~~4627885490~~ 96058 DATE 8-26-2011

OWNER Kiker Builders APPLICANT: PHONE: Home/Cell # 704 888 0233 Business # 704 746-4669

SITE ADDRESS 143 Greenbay Rd M'ville NC OWNER / APPLICANT ADDRESS

SITE DIRECTIONS Hwy 150 W TL Paradise Peninsula TL Greenbay Rd 1st lot on left

SUBDIVISION Greenbay Forest BLOCK / SECTION LOT # 1 LOT AREA 1.94 Acre DESIGN FLOW 480gpd L.T.A.R. .3

Septic Tank 1000 Gallons: STB 312 Date 4-2-12 ☒ New System ☐ Repair ☐ Expansion System Type I II III IV V VI

Pump Tank 1000 Gallons: PT 283 Date 3-2-12 System Description: Pump-LP-Panel Block

Pump Make Gould's Model WE0312M Serial # Repair System Description: Same

No. Nitrification Fields: 1 No. Lines 3 Linear Feet ~~300~~ 270 Maintenance Agreement Required ☒ YES ☐ NO


Trench Width 24" min. Max. Trench Bottom Depth 36" Gravel Depth N/A ☐ GRAVITY ☒ PRESSURE

☒ Residence No. Bedrooms 4 ☐ Business No. Persons ☐ Other No. Employees ☒ Slab ☒ Crawl Space ☐ Basement w/plumbing ☐ Basement w/o plumbing


Water Supply: ☒ Private ☐ Public ☐ Community

Comments / Conditions 10/18/11 2nd trench Solid pipe @ 51' & @ 57' PL 107.42. 3rd trench Solid pipe @ 65' PL 155.20 Must maintain 100ft setback between well & Septic. See revised site plan for exact drive. 60 Panels installed 5/16" hole drilled

INITIAL SITE SKETCH

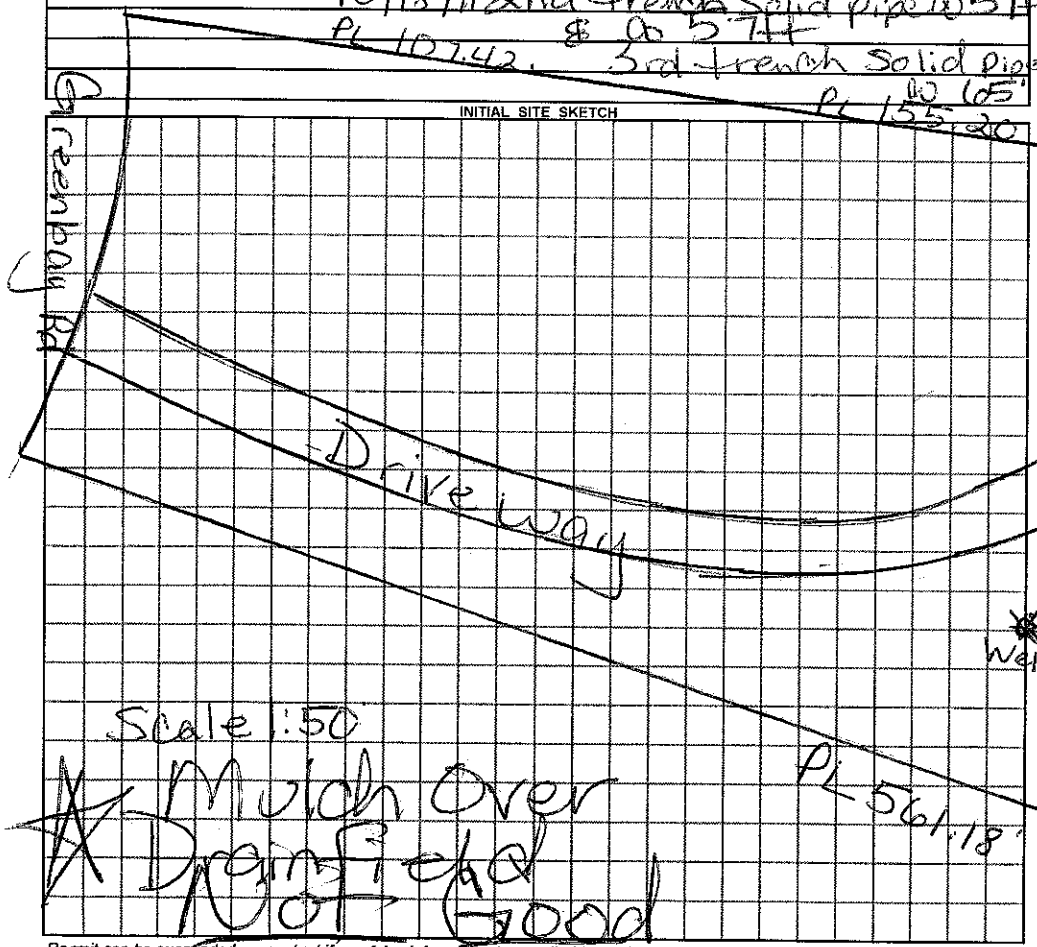

AS BUILT SKETCH

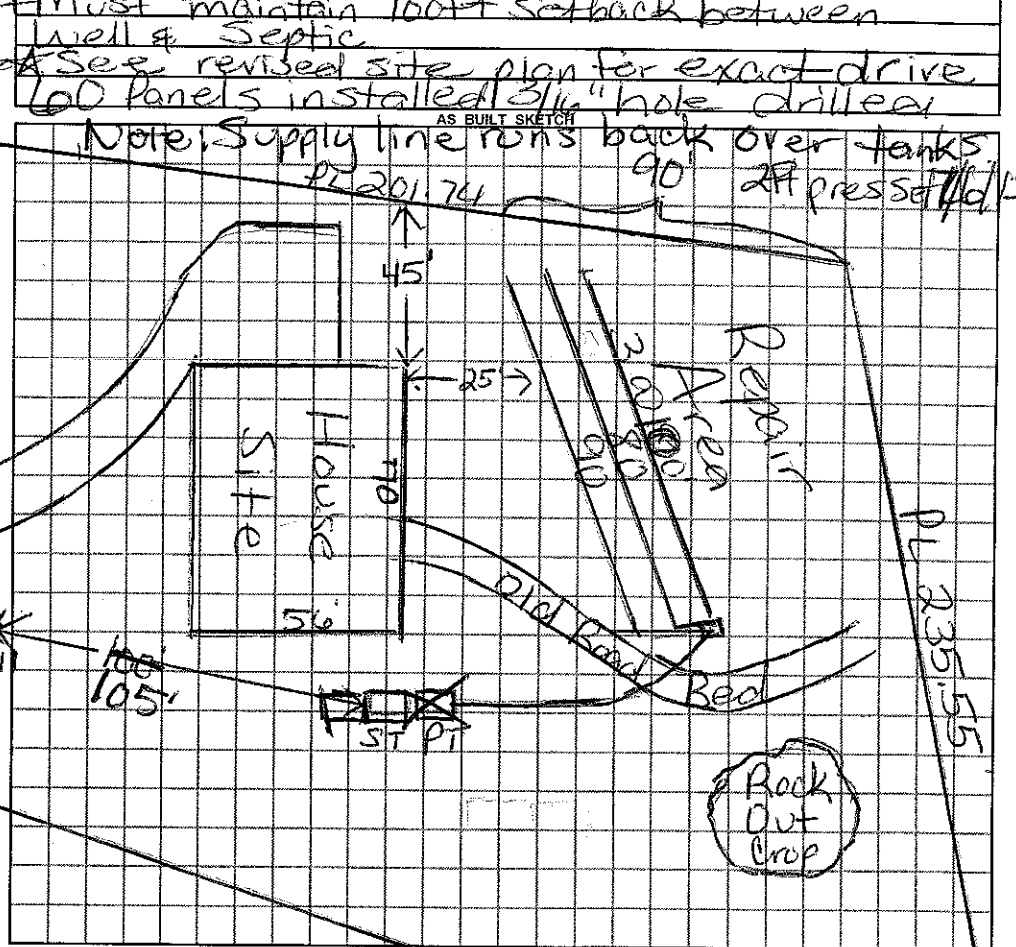

Permit can be suspended or revoked if any false information is supplied toward securing the permit / any unauthorized changes are made to the site / any unauthorized changes are made in the installation of the system.

☐ ***IMPROVEMENT PERMIT*** *with plat valid without expiration.* ☐ ***IMPROVEMENT PERMIT*** *with ~~plat valid without expiration.~~ site plan valid 60 mo.* ☐ ***AUTHORIZATION TO CONSTRUCT*** valid for period equal to IMPROVEMENT PERMIT--not to exceed 60 mo

Owner / Applicant Signature: Date

IMPROVEMENT PERMIT by: Maria H Cole REHS Date 8/26/11

AUTHORIZATION TO CONSTRUCT by: Maria H Cole REHS Date 8/29/11

YOU SHOULD CONTACT A LOCATOR SERVICE PRIOR TO ANY EXCAVATION

Installed by: Ralph Hill

OPERATION PERMIT by: Maria H Cole REHS Date 7/6/12

Existing System Inspected by: REHS Date

White Copy – Environmental Health YELLOW COPY (Final) Owner / Applicant PINK COPY (Initial) Owner / Applicant