
As Built Drawing
verified 11/20/19

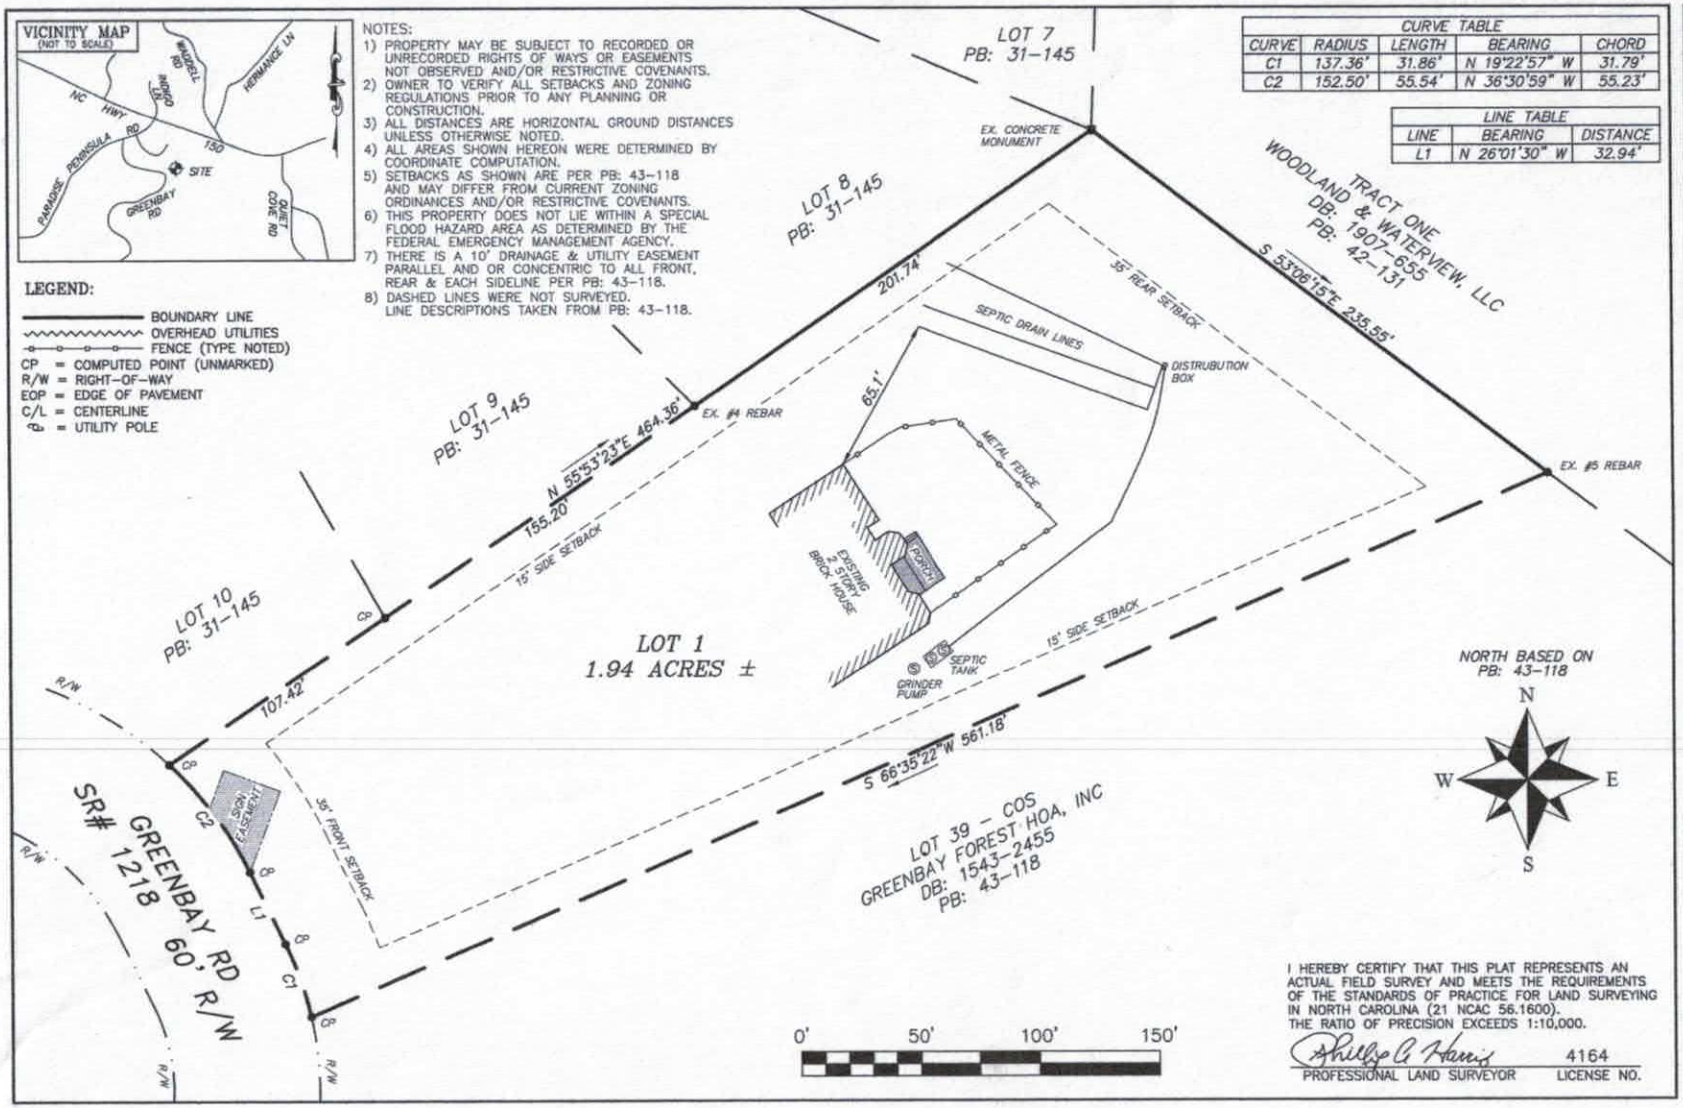

CURVE TABLE				
CURVE	RADIUS	LENGTH	BEARING	CHORD
C1	137.36'	31.86'	N 19°22'57" W	31.79'
C2	152.50'	55.54'	N 36°30'59" W	55.23'

LINE TABLE		
LINE	BEARING	DISTANCE
L1	N 26°01'30" W	32.94'

I HEREBY CERTIFY THAT THIS PLAT REPRESENTS AN ACTUAL FIELD SURVEY AND MEETS THE REQUIREMENTS OF THE STANDARDS OF PRACTICE FOR LAND SURVEYING IN NORTH CAROLINA (21 NCAC 56.1600). THE RATIO OF PRECISION EXCEEDS 1:10,000.

Phillip G. Harris 4164
PROFESSIONAL LAND SURVEYOR LICENSE NO.

HARRIS LAND SURVEYING, PLLC
FIRM LICENSE #: P-1295
4080 DAVIS RD
MOORESVILLE, NC 28115
704-400-6800
phillip.harris3@gmail.com

PHYSICAL SURVEY FOR
SHAD E. AUL & CHRISTY H. AUL
ALL OF LOT 1 OF GREENBAY FOREST
REFERENCES: DB: 2027-1140 & PB: 43-118

DRAWN BY:	SRW & PAH
DRAWING FILE NAME:	19241.DF1
PROJECT NO:	19241
PROPERTY ADDRESS:	143 GREENBAY RD MOORESVILLE, NC 28117
DATE:	NOVEMBER 13, 2019
SCALE:	1" = 50'
	DAVIDSON TOWNSHIP
	IREDELL COUNTY, NC

SEAL:
NORTH CAROLINA PROFESSIONAL LAND SURVEYOR SEAL L-4164