# IREDELL COUNTY HEALTH DEPARTMENT

STATESVILLE 704-878-5305 MOORESVILLE 704-664-5281

130.00 Paid 3:30

## IMPROVEMENT PERMIT / AUTHORIZATION TO CONSTRUCT / OPERATION PERMIT / EXISTING SYSTEM INSPECTION

PERMIT# 123155 PIN# 4627-89-6300 DATE 8/10/04

OWNER OR CONTRACTOR Flagship Builders LLC PHONE: Business 980-721-1249 Home

ADDRESS PO Box 4568 Mooresville NC 28117

LOCATION 1505 TL Paradise Peninsula, TL Red Brook Ln, on Rt at End

SUBDIVISION Pinnacle Shores BLOCK / SECTION 4 LOT 8 LOT AREA 0.9 Ac SITE CLASS. PS DESIGN FLOW 480 L.T.A.R. .25

Septic Tank: 1000 Gallons; STB 794 Date 12-14-04

Pump Tank: Gallons; PT Date

Pump Make: Model Serial No.

Nitrification Field: No Fields 1 Square Feet 1440 Linear Feet 480

No Lines 5 Trench Width 36" Max Trench Bottom Depth 36" Gravel Depth —

☒ New System ☐ Repair System Type: I, II, III, IV, V, VI

System Description: Gravity 25% Reduct.

Repair System Description: LP Panel Block

Maintenance Agreement Required: ☐ Yes ☒ No

☒ House/Mod. Home ☐ Mobile Home ☐ Business ☐ Other

No. Bedrooms 4 No. Bathrooms No. Employees


☐ Slab ☐ Crawl Space ☒ Basement w/plumbing ☐ Basement wo/plumbing

Water Supply: ☐ Individual ☐ Public ☒ Community


Comments:/Conditions: 1"=50'

Comments:/Conditions: Installed 5 lines @ 94' each Plastic Chambers

INITIAL SITE SKETCH

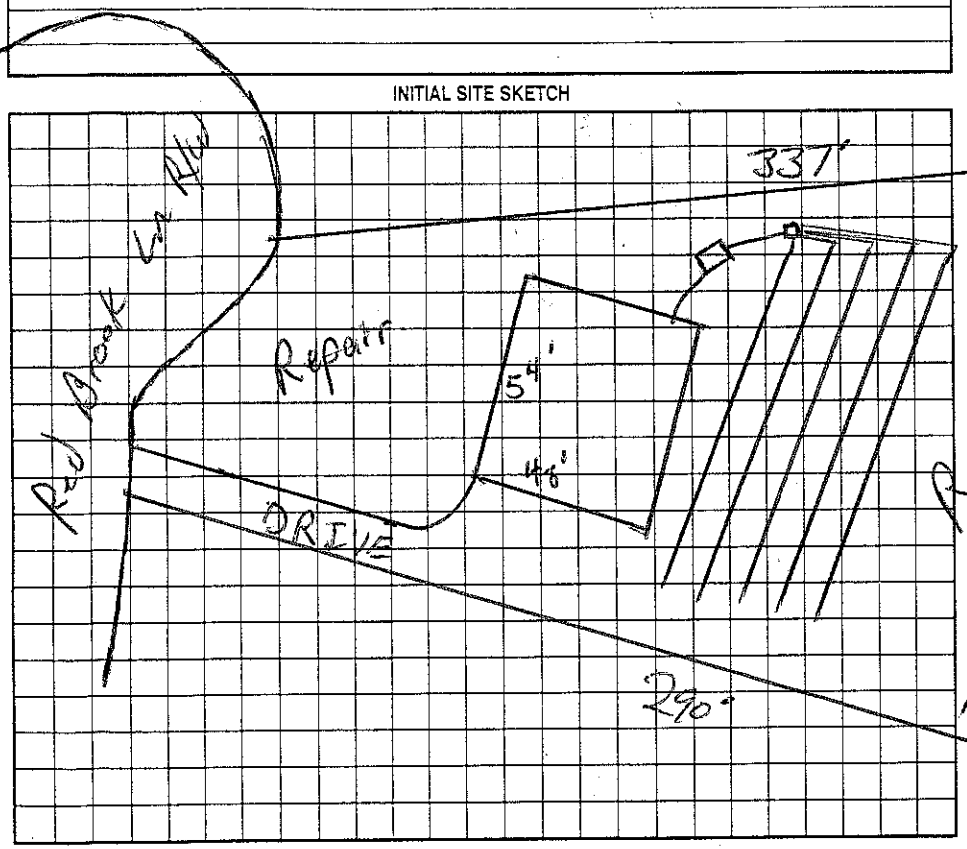


AS BUILT SKETCH

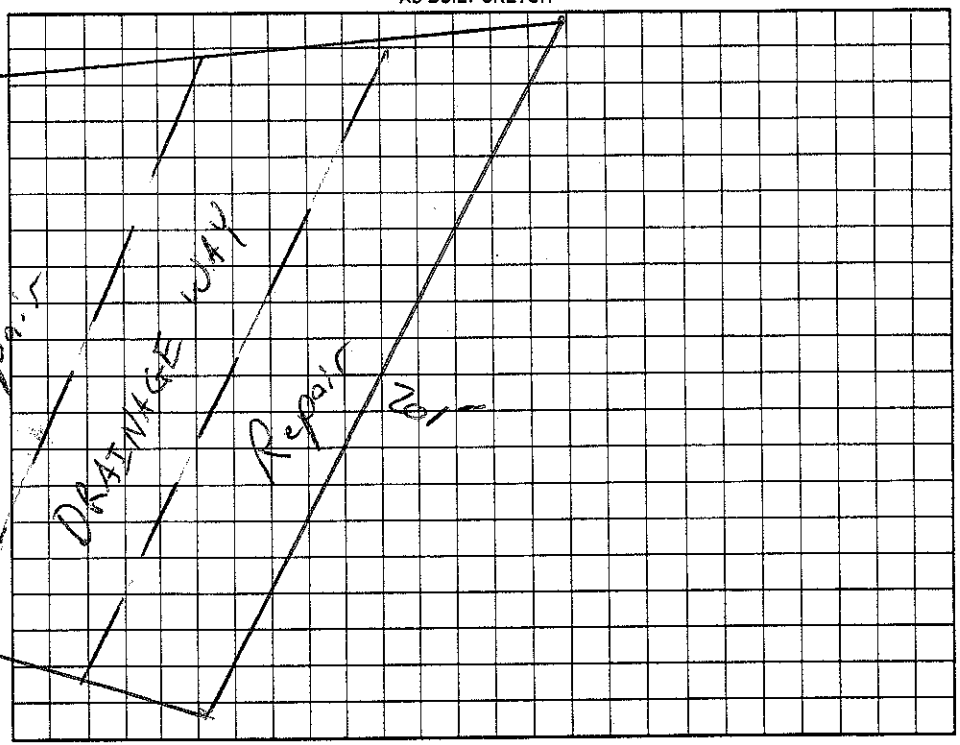


Permit can be suspended or revoked if any false information is supplied toward securing the permit/any unauthorized changes are made to the site/any unauthorized changes are made in the installation of the system. Improvement Permit with plat valid without expiration. Improvement Permit with site plan valid for sixty months. Authorization to Construct is valid for a period equal to that of Improvement Permit – not to exceed sixty months.

Signed: date 8/11/04 Installed by: Richard Abernathy

Improvement Permit by: RS date 8/10/04 Operation Permit by: date 1/21/05

Authorization to Construct by: RS date 8/10/04 Existing System Inspection by: date

HEALTH DEPT. COPY: WHITE OWNER COPY (FINAL): YELLOW OWNER COPY (INITIAL): PINK